

UNITED STATES
DEPARTMENT OF THE INTERIOR
BUREAU OF LAND MANAGEMENT

34165


13

37831

SECTION 15

Oregon State Water Filings

TOWNSHIP 40S, RANGE 22E, W. M.

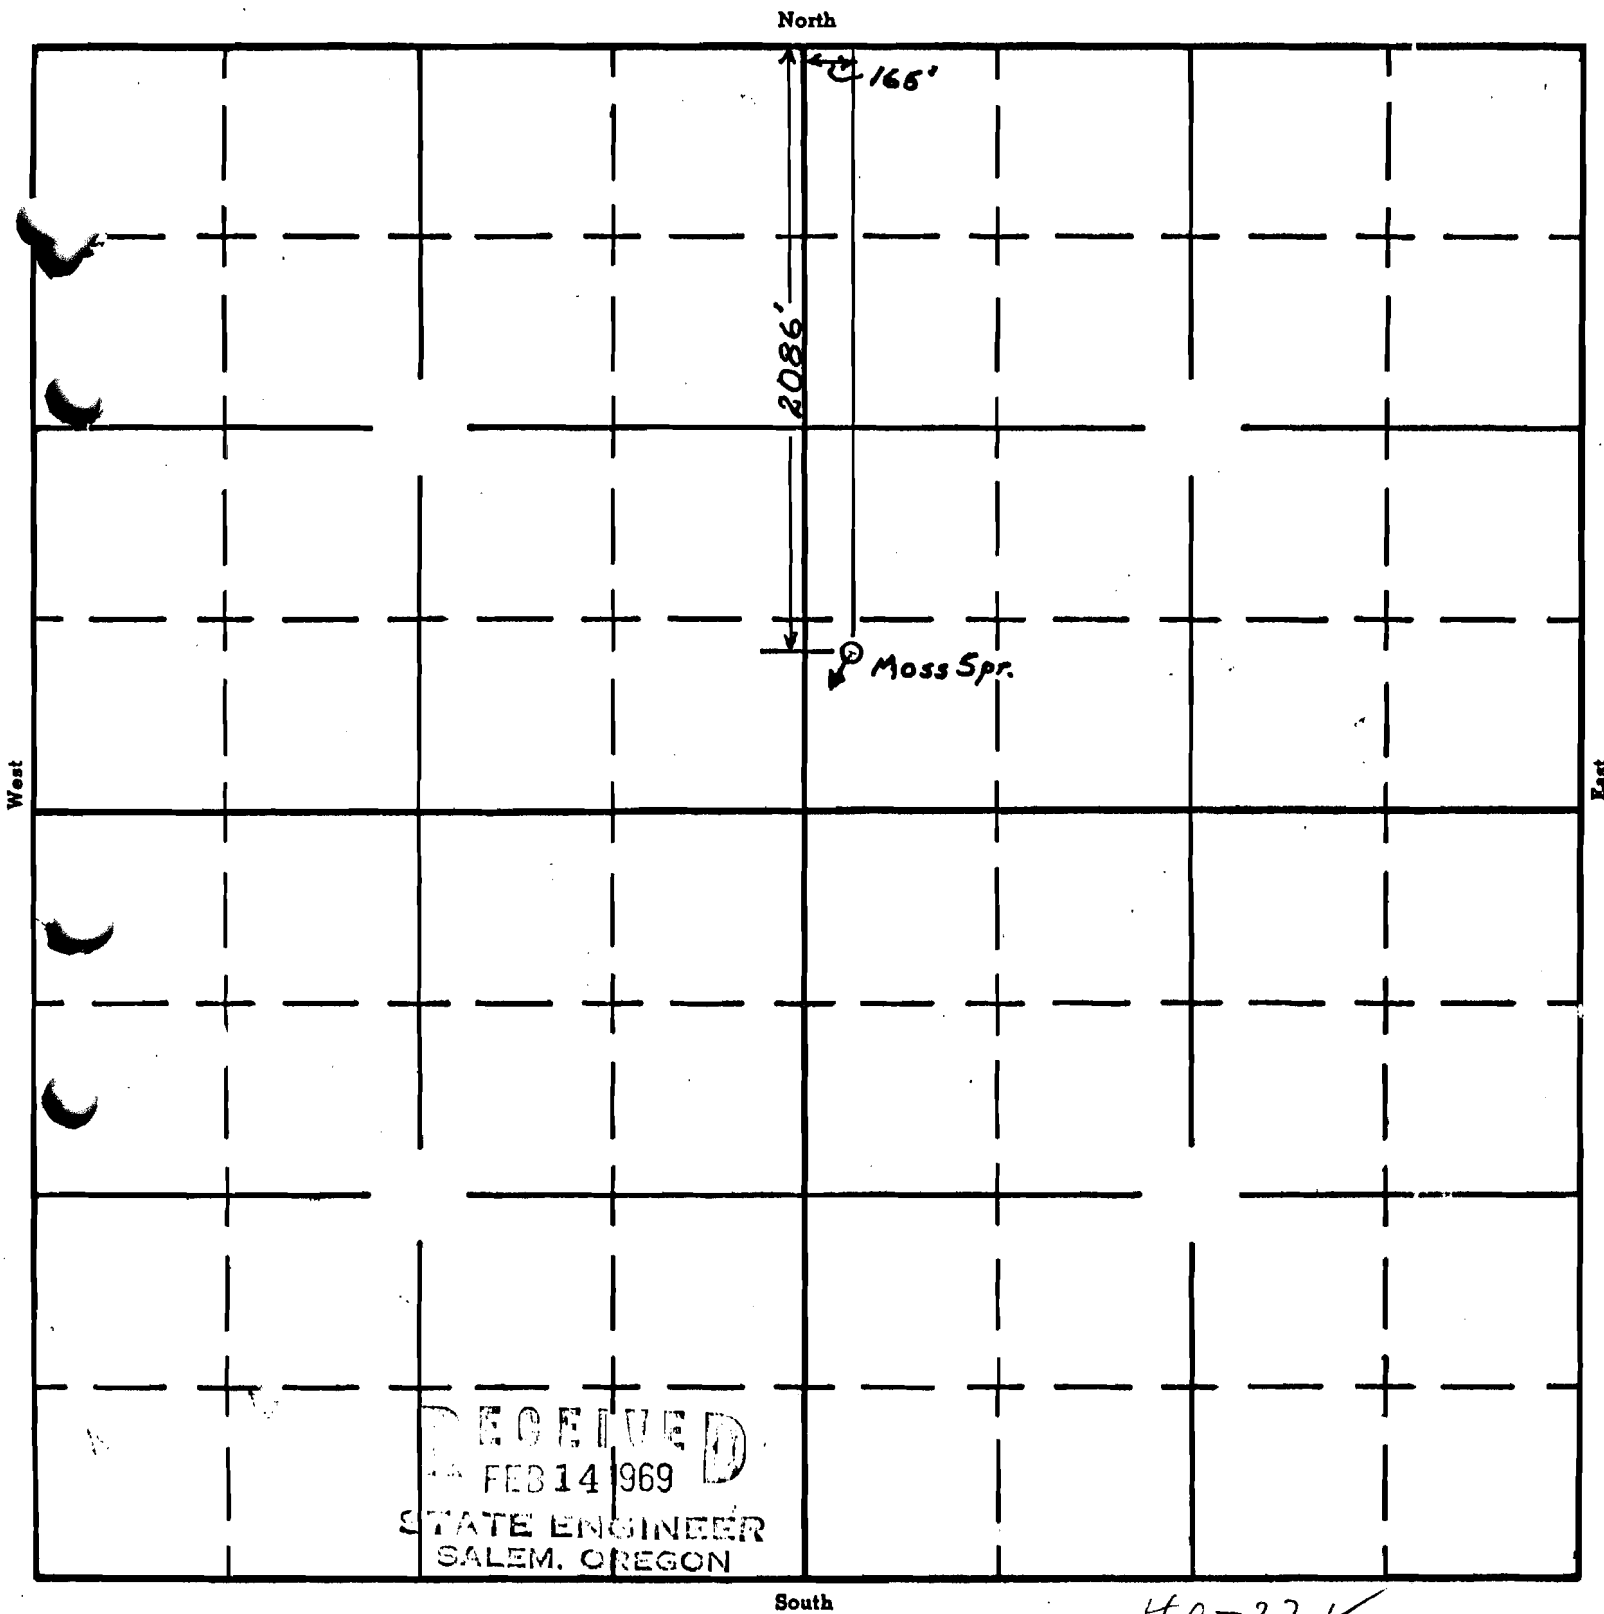

40-22 ✓

APPLICATION No. 45770
PERMIT No. 34165