


T.17S.R.2W.W.M.

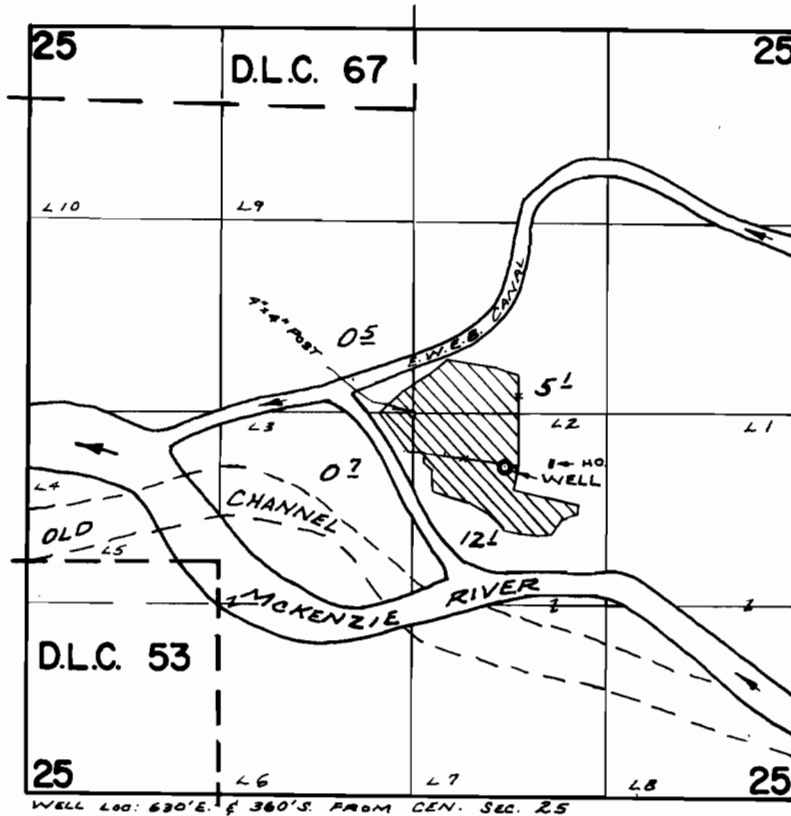

**FINAL PROOF SURVEY**  
UNDER

Application No. G-3536 Permit No. G-3328  
IN NAME OF

FLOYD A. GREEN

Surveyed Nov. 12, 1970, by R. MUCKEN