


T.17-18S.R.6W.W.M.

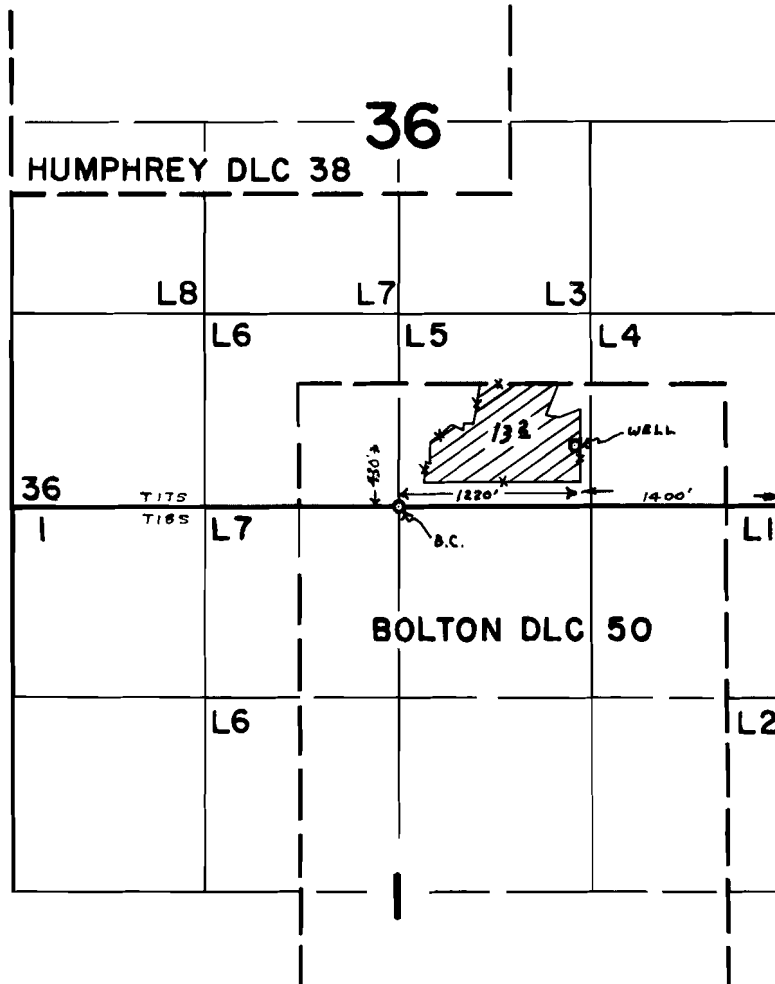

FINAL PROOF SURVEY UNDER

Application No. G-4/38 Permit No. G-3888
IN NAME OF

OSCAR E. WILLIAMS

Surveyed OCT. 7 1970, by G. BACA