


# T.18S. R.5 W.W.M.

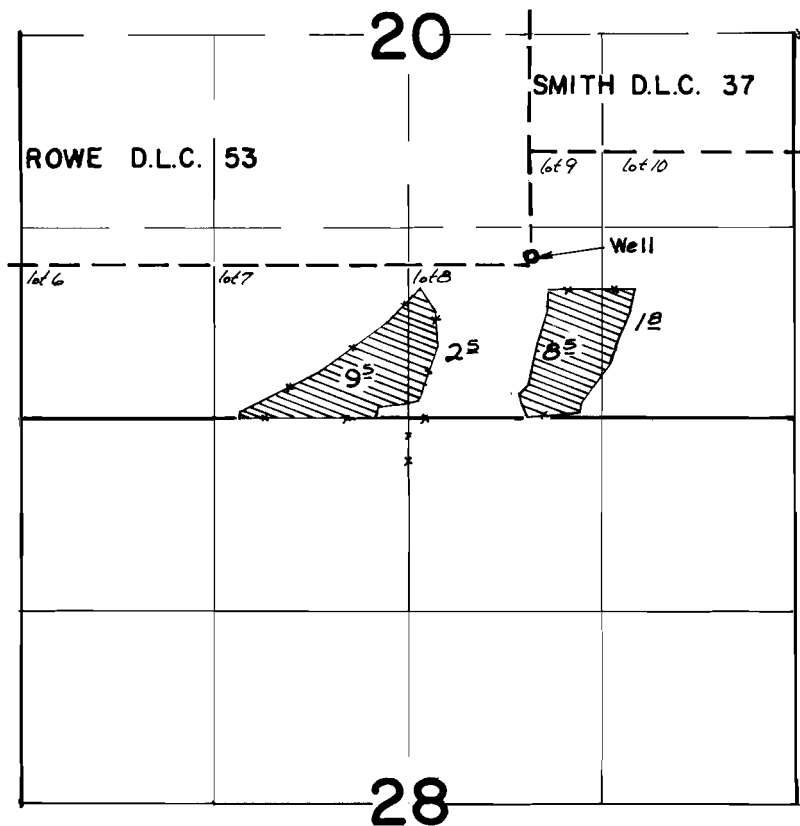

Well loc. 1110' N. & 840' E. fm. SW Gr. Sec. 20.

## FINAL PROOF SURVEY UNDER

Application No. G 4141..... Permit No. G 3890.....  
IN NAME OF

HUBERT DIESS.....

Surveyed 19 NOV..... 1970., by G. BACA.....