


# T.16 S.R.3 & 4 W.W.M.

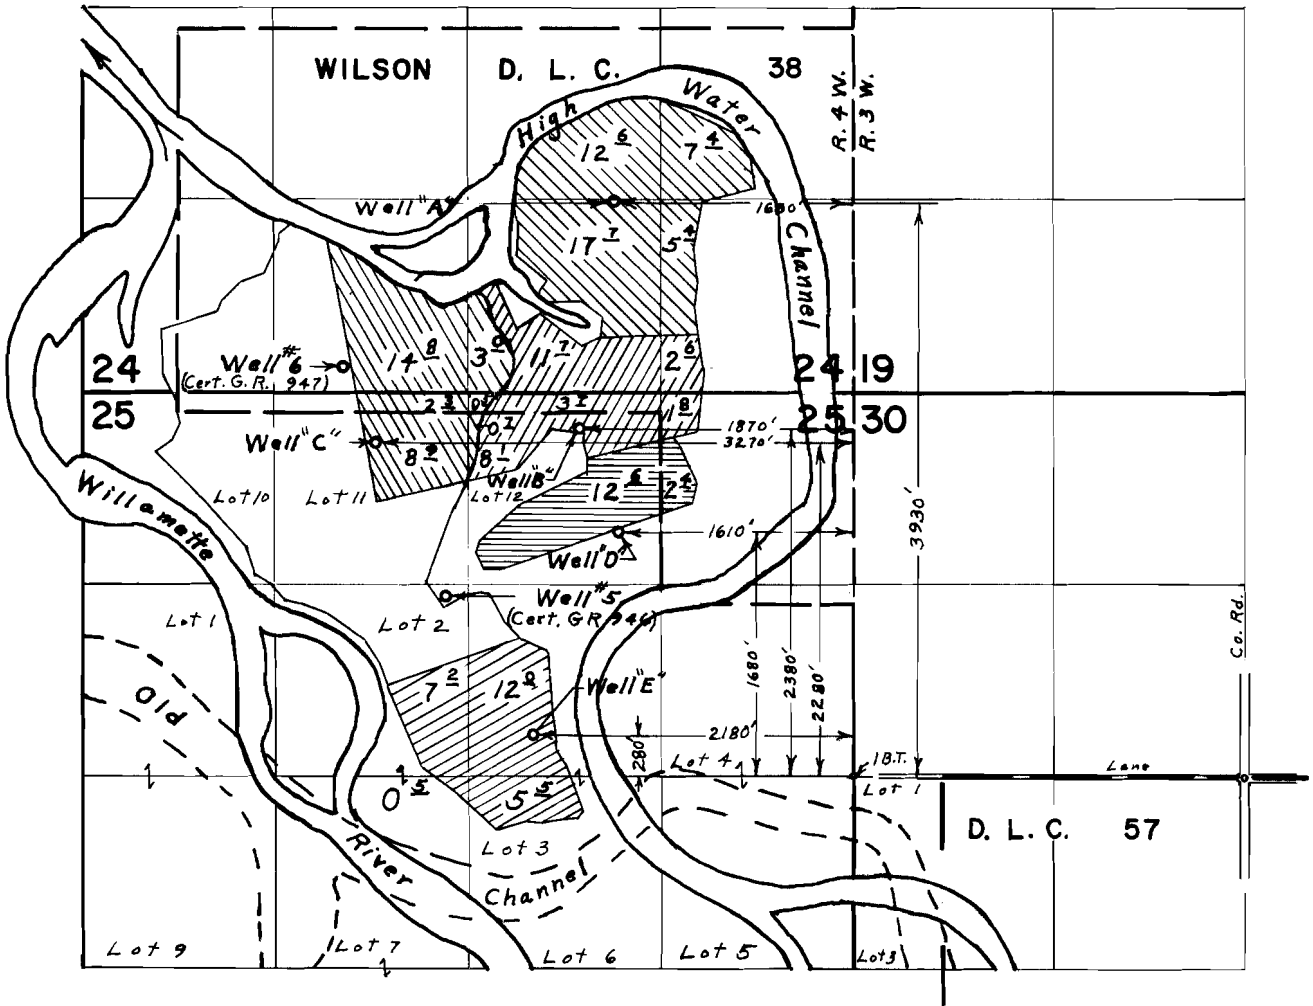

## FINAL PROOF SURVEY

UNDER

G-4218  
G-4219  
G-4220  
G-4221

G-3998  
G-3999  
G-4000  
G-4001  
G-4002



Application No. G-4222 Permit No. G-3998

IN NAME OF

**GREEN BROS.**

Surveyed April 25, 1969, by L. E. Gould