




# T. 16 S. R. 3 & 4 W. W. M.

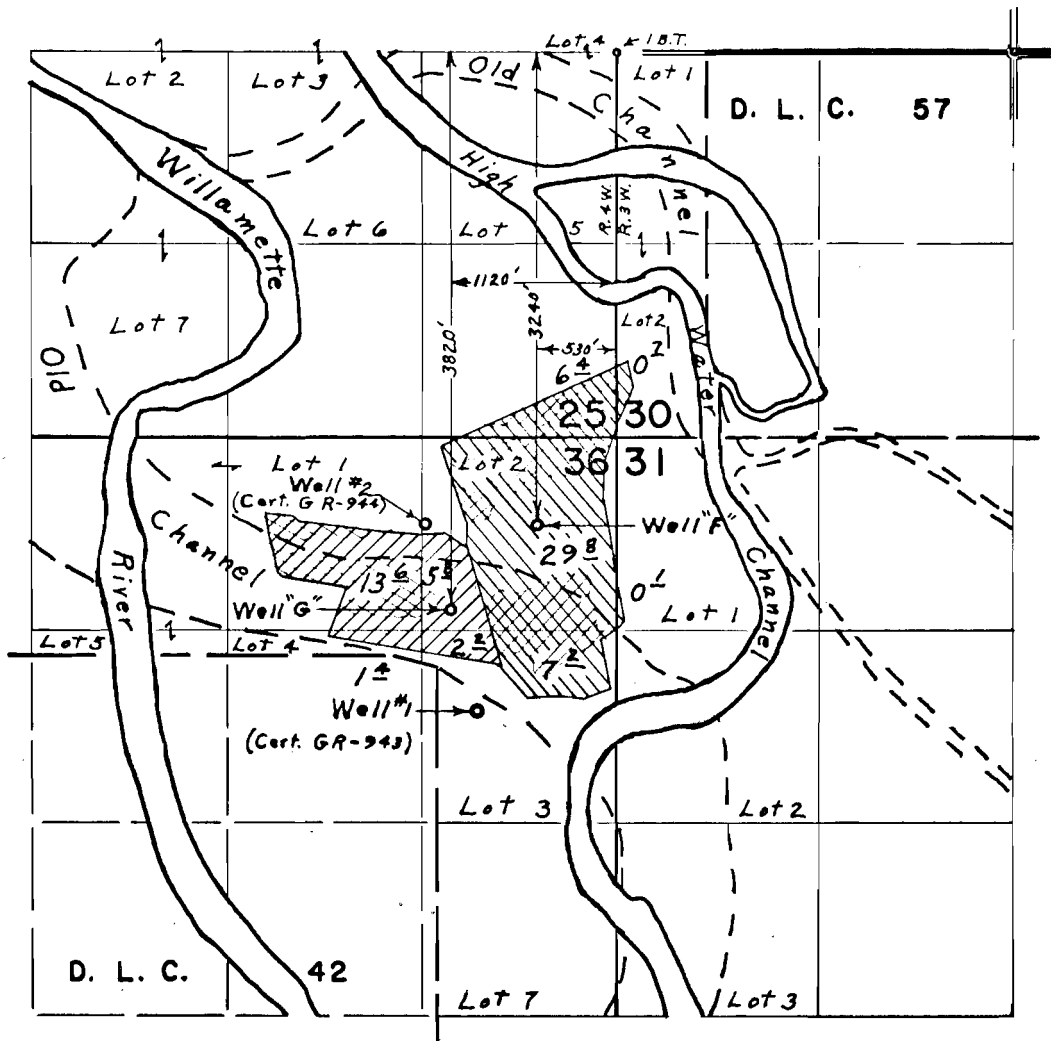

## FINAL PROOF SURVEY UNDER

Application No. G-4223      G-3987        
 Application No. G-4224      Permit No. G-3988      

IN NAME OF  
**GREEN BROS.**

Surveyed April 25, 1969, by L. E. Gould