
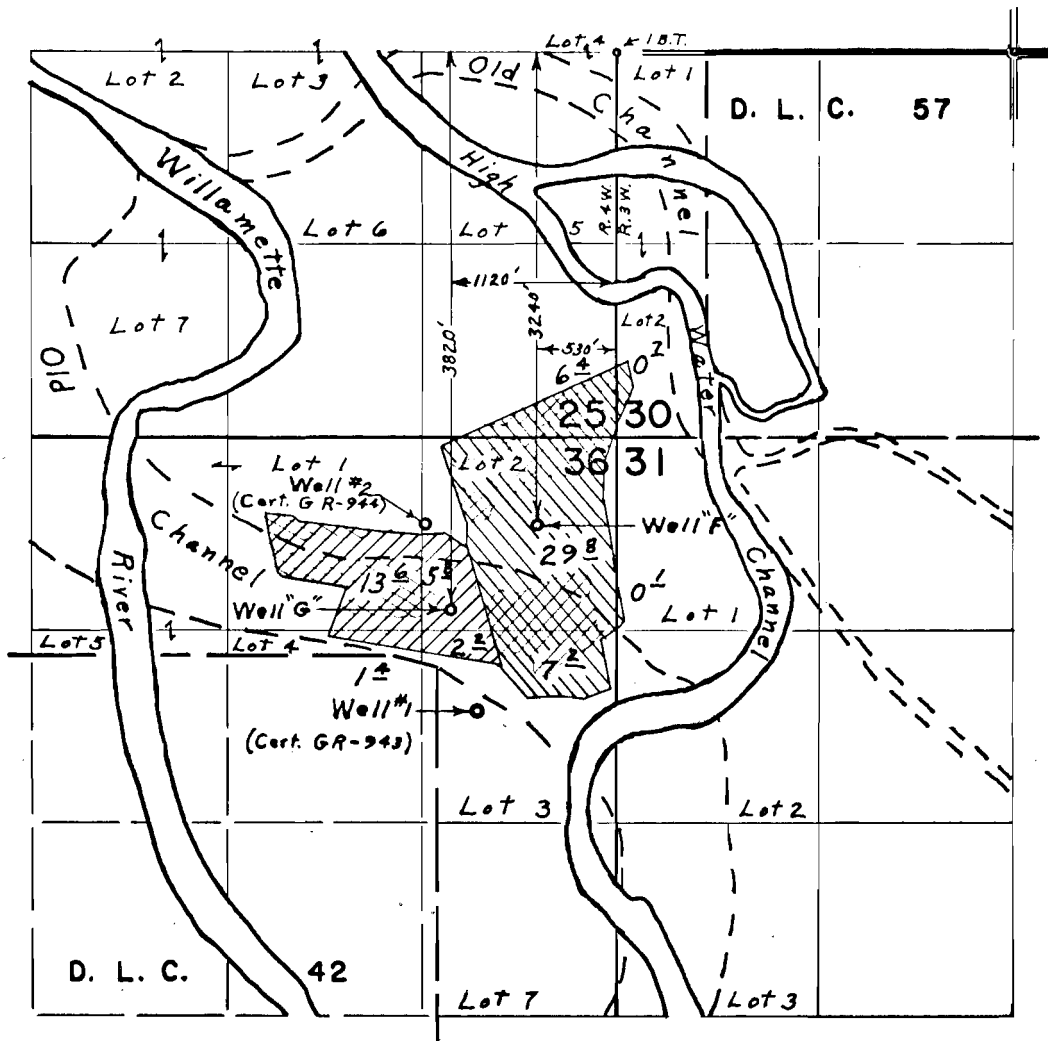



T. 16 S. R. 3 & 4 W. W.M.

 

FINAL PROOF SURVEY UNDER

Application No. G-4223 G-3987 
 Application No. G-4224 Permit No. G-3988 

IN NAME OF
GREEN BROS.

Surveyed April 25, 1969, by L. E. Gould