


T.17S.R.6W.W.M.

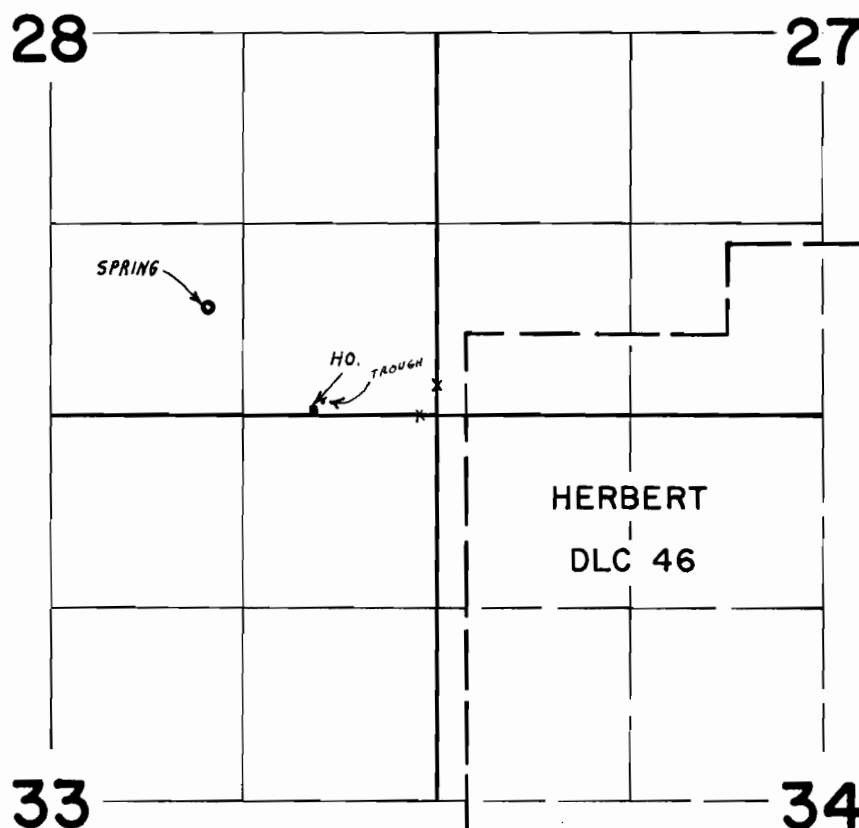

SPRING LOC. 750' N. & 1560' W. FROM SEC COR. SEC. 28

FINAL PROOF SURVEY


Application No. 42643 and 31850

of 1901

HENRY C. & OPAL L. PIERCE

Surveyed OCT. 6, 1970, by G. BACA