


T.17S.R.2W.W.M.

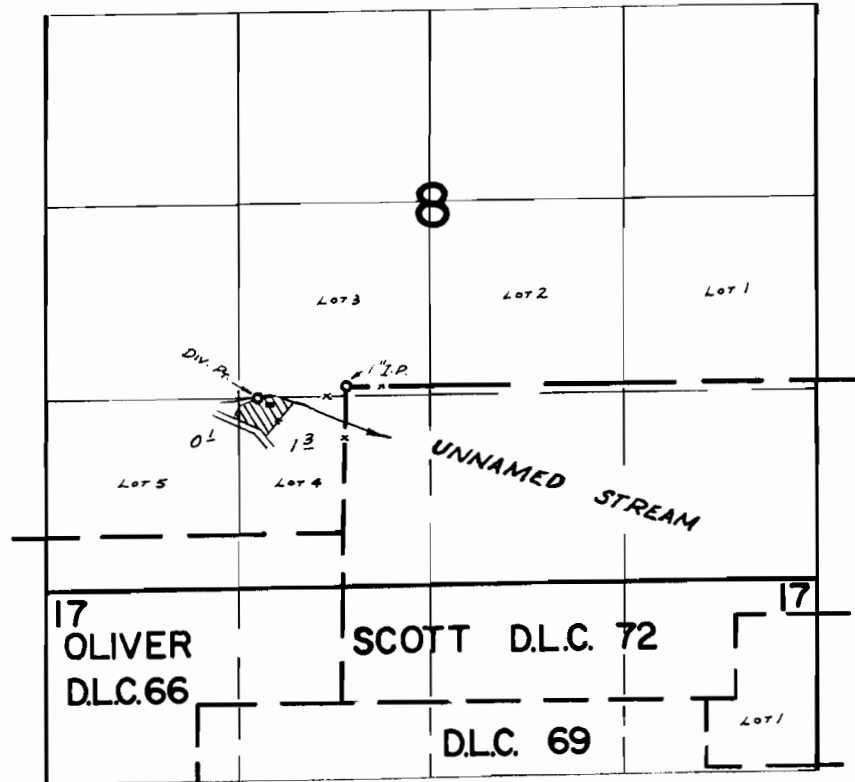

*Div. Pt. Loc: 70' S. & 610' W. FROM N.W. COR. SCOTT D.L.C. 72*

42759

31973

VIOLA HILES

OCT. 16, 70 R. MUCKEN