


T.17S.R.1W.W.M.

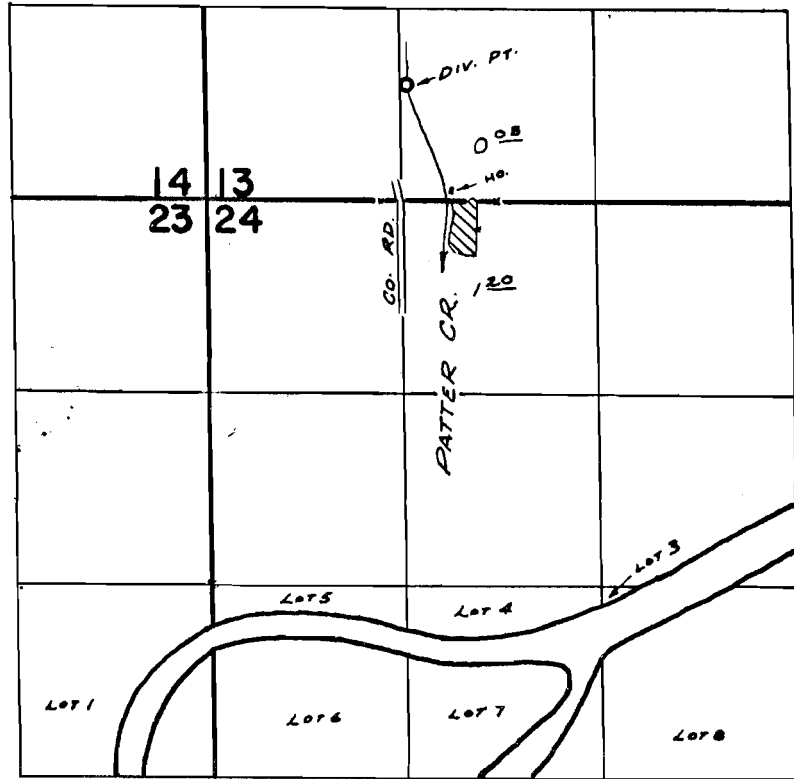

DIV. PT. LOC: 780' N. 5° 30' E. FROM S.W. COR. S.E. 1/4 SW 1/4 SEC. 13

FINAL PROOF SURVEY

UNDER

Application No. 19745 Permit No. 32690

IN NAME OF

MELVIN & BERTHA V. COUCH

Surveyed OCT. 13, 1970, by R. MUCKEN