


T.11S.R.2W.W.M.

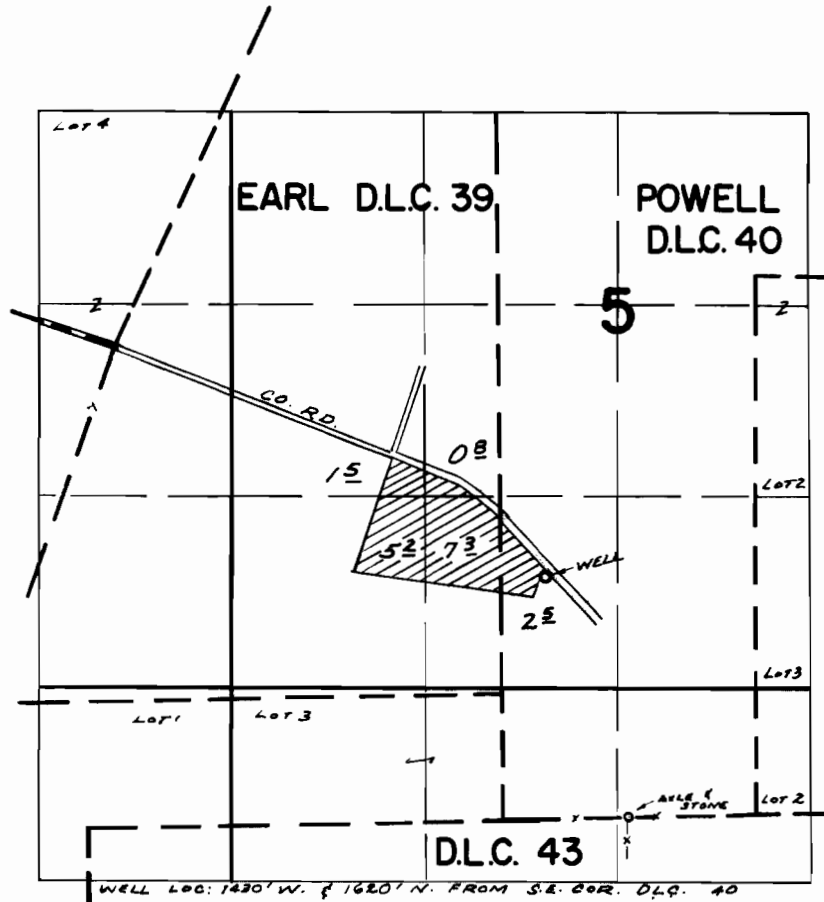

FINAL PROOF SURVEY
UNDER

Application No. G-3530 Permit No. G-3322
IN NAME OF

GEORGE E. & HARRIETTA R. DWYER

Surveyed MAY 28, 1970, by R. MUCKEN.