


# T.9S.R.2E.W.M.

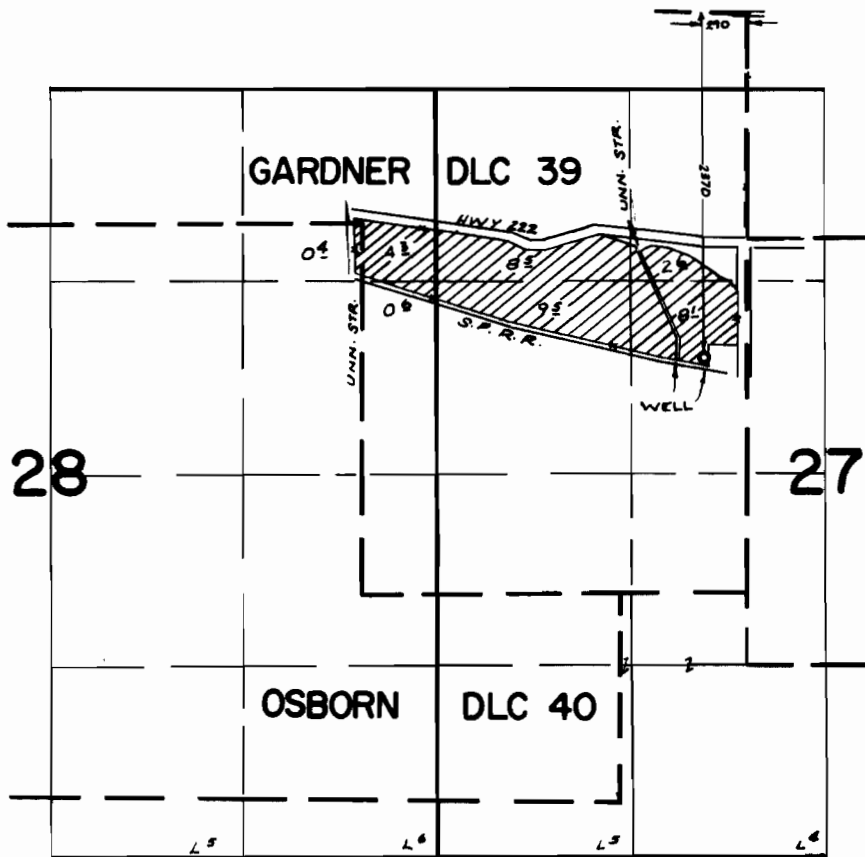

## FINAL PROOF SURVEY UNDER

Application No. G-3891 Permit No. G-3475  
IN NAME OF

BUGABOO TIMBER COMPANY INC.

Surveyed MAY 5, 1970, by R. MUCKEN