


4808

TWP 2N R 12 E W M

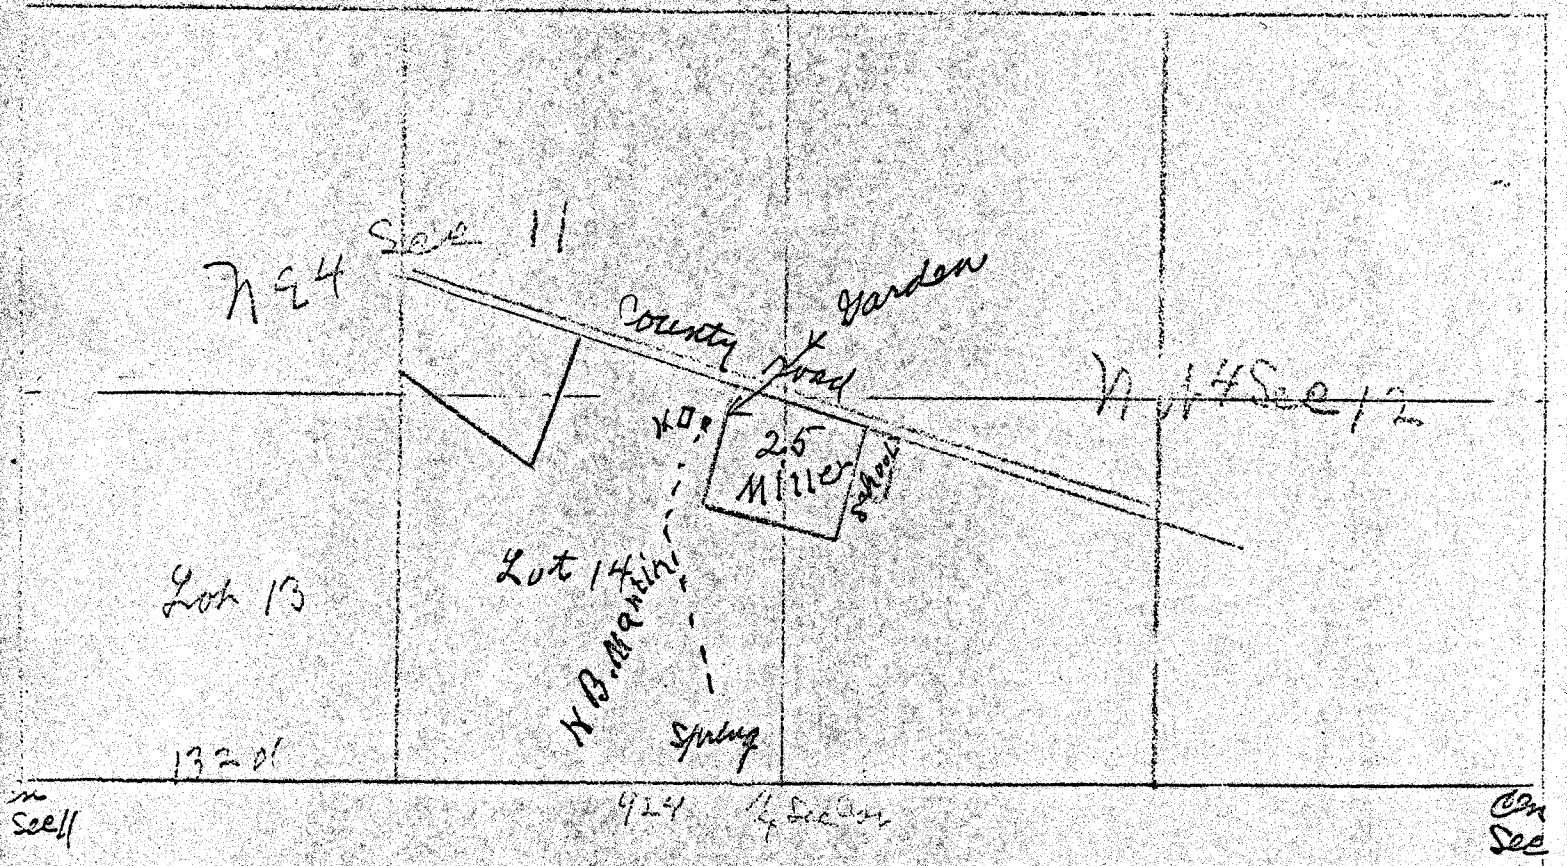

Map of N B Martin pipe Line
 Scale 10 chains to inch

Application No. 7546
 Permit No. 4808

