


# T.10S.R.3W.W.M.

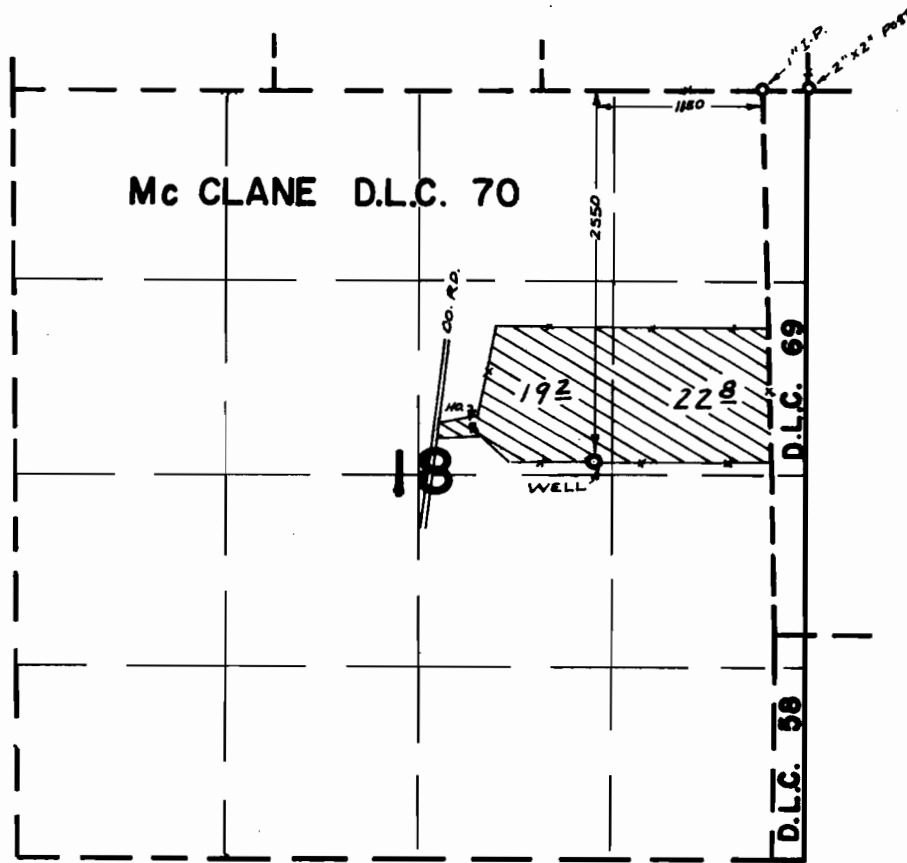

## FINAL PROOF SURVEY

UNDER

Application No. G-4354 Permit No. G-4136

IN NAME OF

**GEORGE L. & DORIS J. ROHNER**

Surveyed APR. 24, 1970, by R. MUCKEN