


# T. 11 S. R. 2 W. W.M.

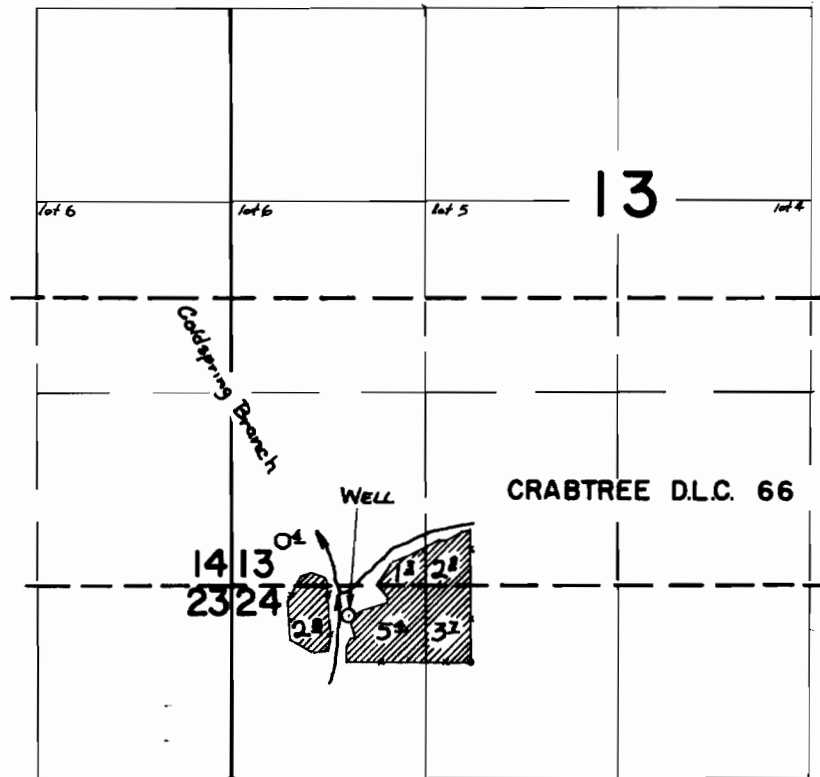

Well loc. 200' S & 800' E. fm. NW Cor. Sec. 24

## FINAL PROOF SURVEY UNDER

Application No. G 4431      Permit No. G 4175  
IN NAME OF

CLIFFORD & LOLA WHISENHUNT

Surveyed 31 MAR. 1970, by D. R. BUELL