


T.11S.R2W.W.M.

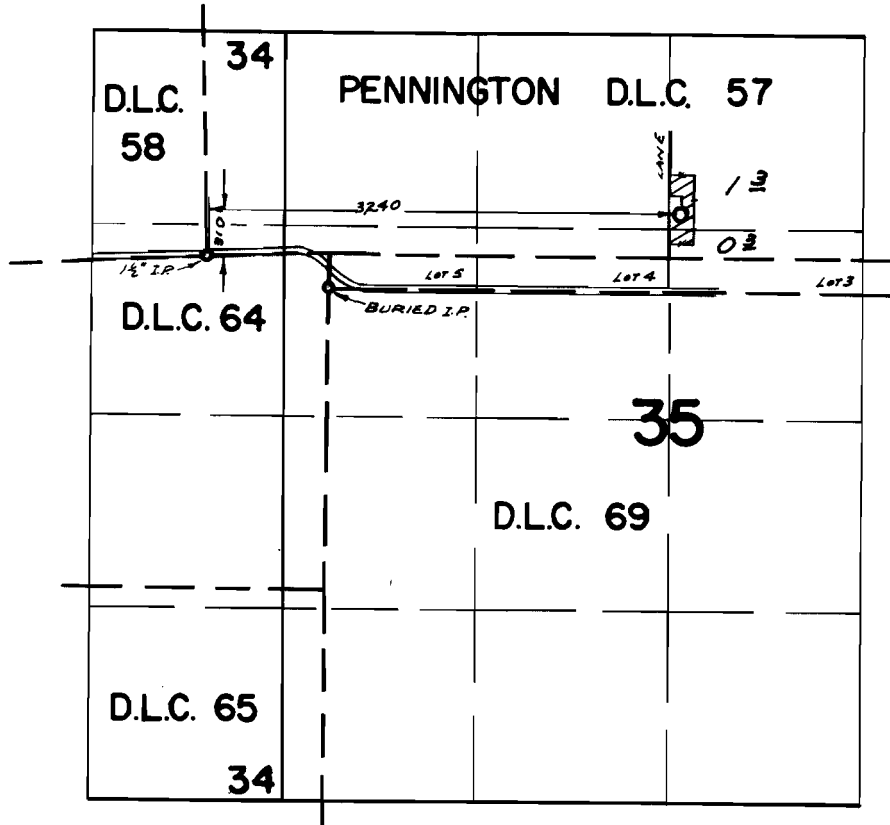

FINAL PROOF SURVEY UNDER

Application No. G-4793 Permit No. G-4518
IN NAME OF

GEORGE FRITZ

Surveyed MAY 29, 1970, by R. MUCKEN