


T. 13 S. R. 1 W. W.M.

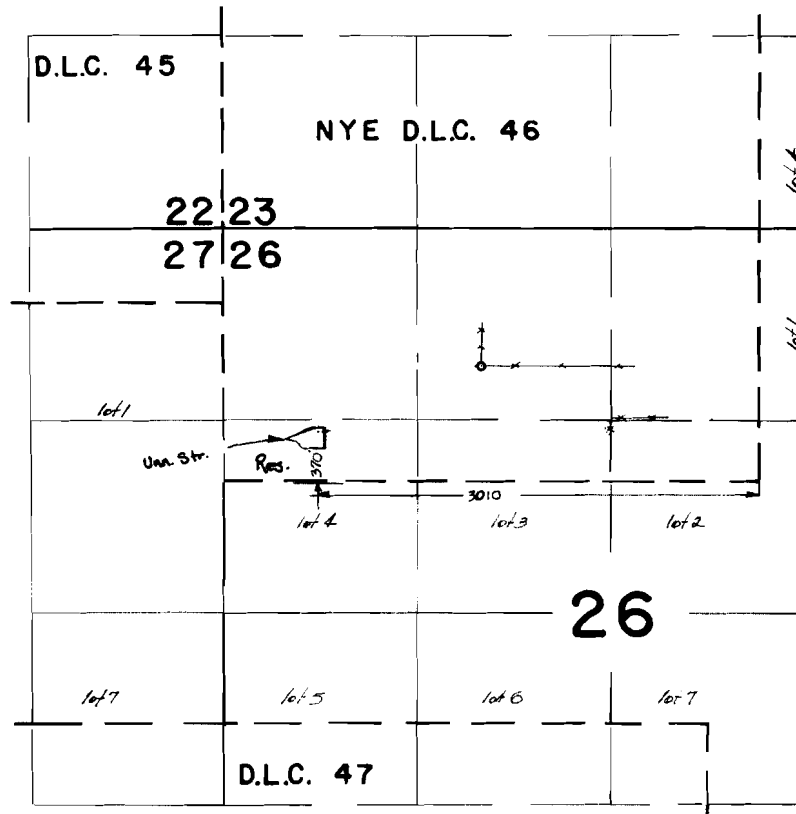

FINAL PROOF SURVEY
UNDER

Application No. R 43262 Permit No. R 4956
IN NAME OF

FLOYD EMMERT

Surveyed 4 SEPT. 1969, by W. J. RUPPERT