


# T.I.S.R.I.E.W.M.

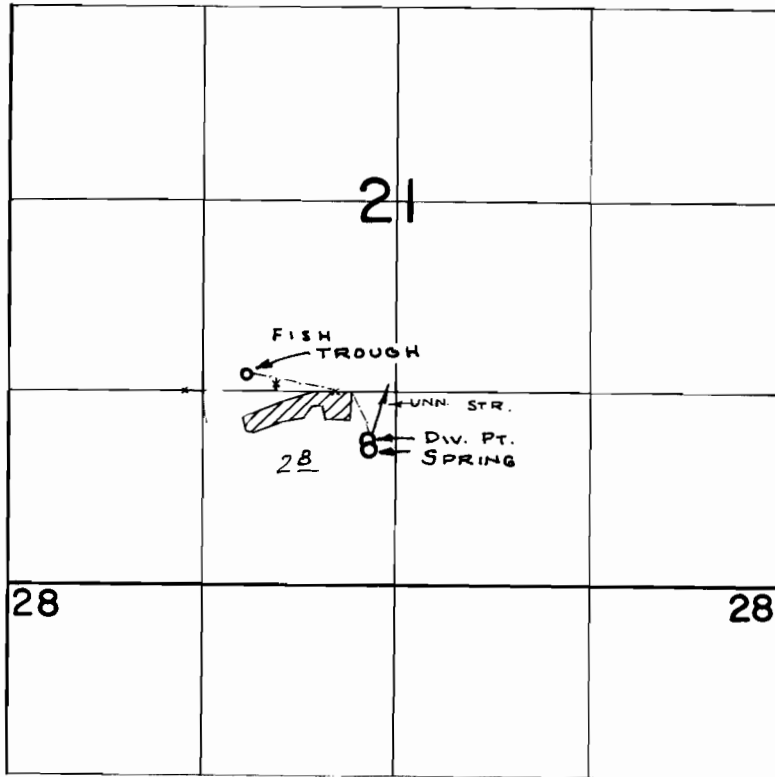

DIV. PT. LOC: 1120'E. & 330'S. } BOTH FROM N.W. COR. SE 4 SW 4  
SPRING LOC: 1130'E & 390'S. } SEC. 21

## FINAL PROOF SURVEY UNDER

Application No. 39775 Permit No. 29573  
IN NAME OF

**ROBERT H. & CHRISTINA K. GENTNER**

Surveyed MAR. 30, 1970, by R. MUCKEN.