


T.IOS.R.I.W.W.M.

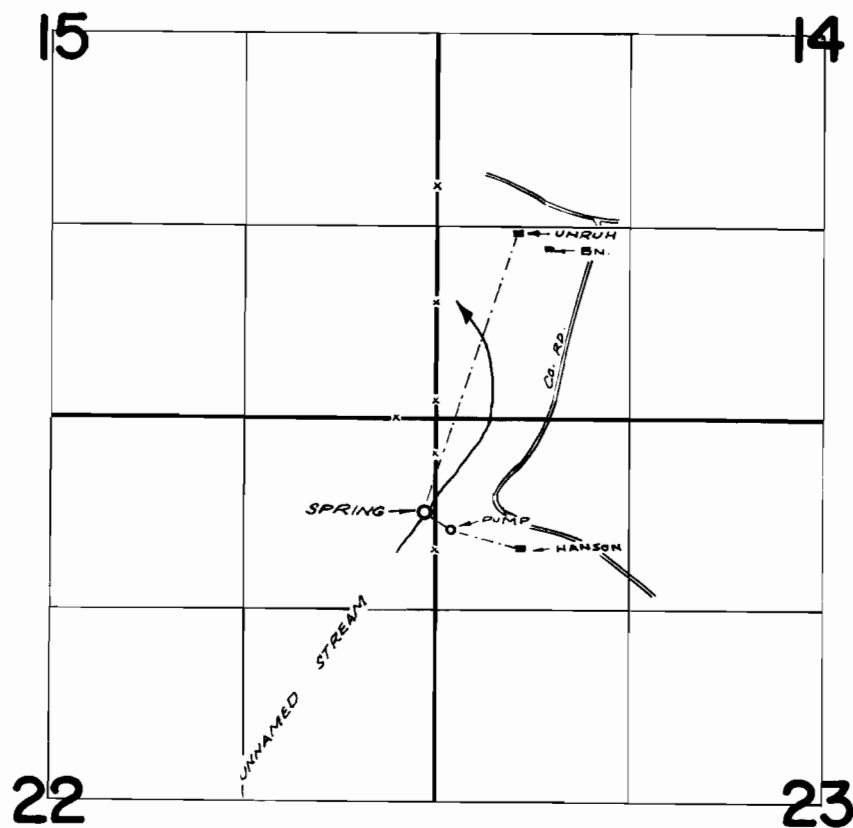

FINAL PROOF SURVEY
UNDER

Application No. 41301..... Permit No. 30840.....
IN NAME OF

CURTIS C. & JANET I. HANSON

Surveyed APR. 7, 1970, by R. MUCKEN.