


T.I.O.S.R.I W.W.M.

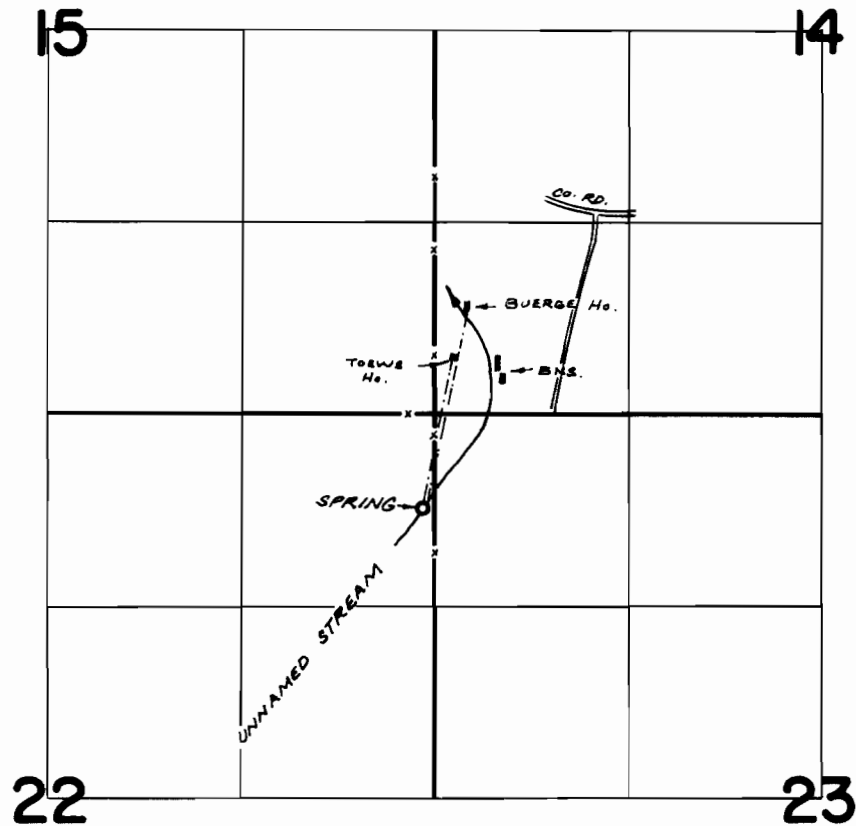

**FINAL PROOF SURVEY**  
UNDER

Application No. 41955 Permit No. 31411  
IN NAME OF

WAYMON & LILLIAN BUERGE

Surveyed APR. 7, 1970, by R. MUCKEN