


T.10S.R.2W.W.M.

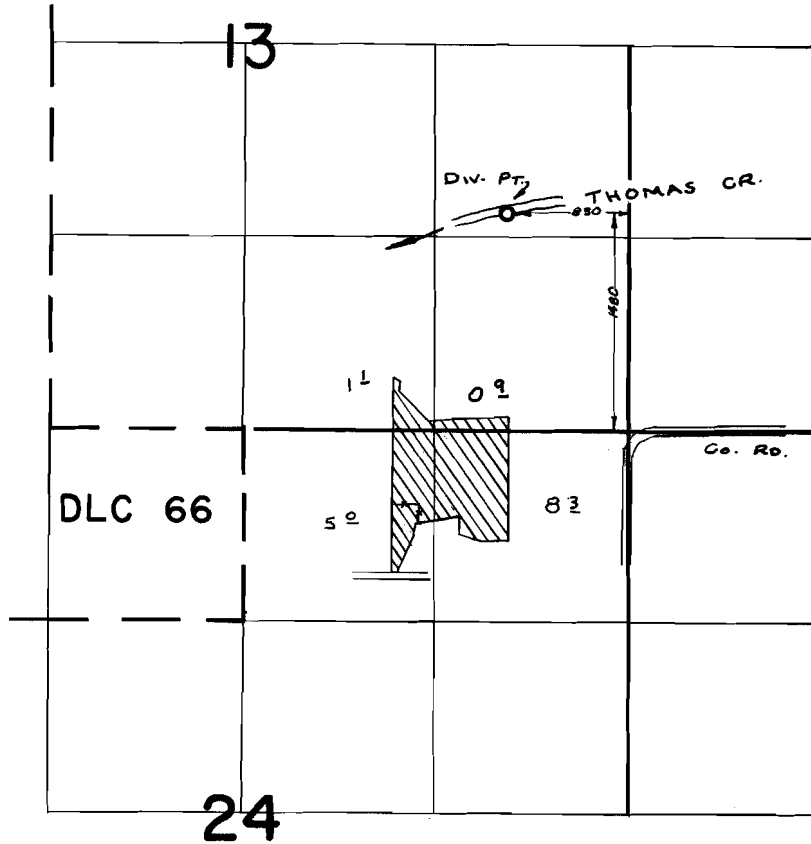

FINAL PROOF SURVEY
UNDER

Application No. 43657 Permit No. 32636
IN NAME OF

JERRY M. FALTUS

Surveyed APR. 2 1970, by R. MUCKEN