


T.11S. R.4W. W.M.

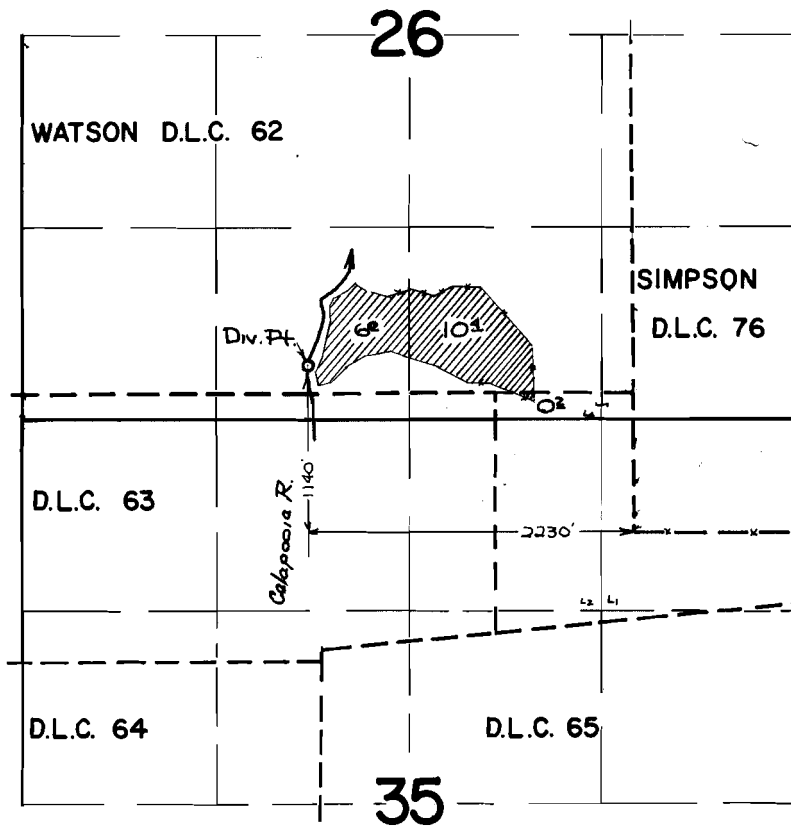

FINAL PROOF SURVEY UNDER

Application No. 43658 Permit No. 32637
IN NAME OF

EDWARD W. & RUTH L. JENKS

Surveyed 10 JULY 1970, by D.R. BUELL