


T.13 S. R.1 W. W. M.

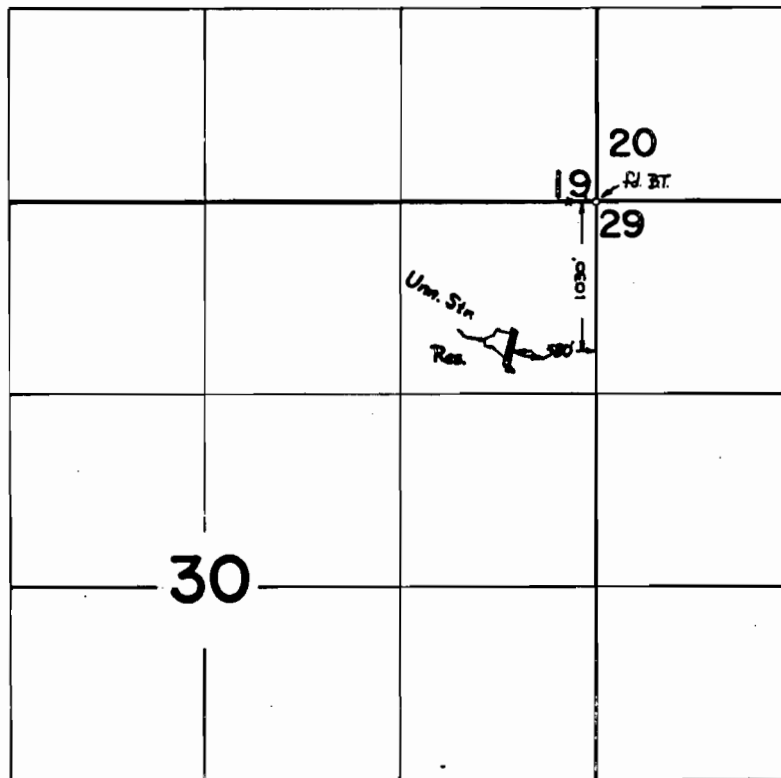

FINAL PROOF SURVEY

UNDER

Application No. **R 43694** **43759** Permit No. **R 5019** **32666**

IN NAME OF

COE & MIRIAM LEAVENGOD

Surveyed **3 APR** 19 **70**, by **D.R. BUELL**