


T.13 S. R.1 W. W. M.

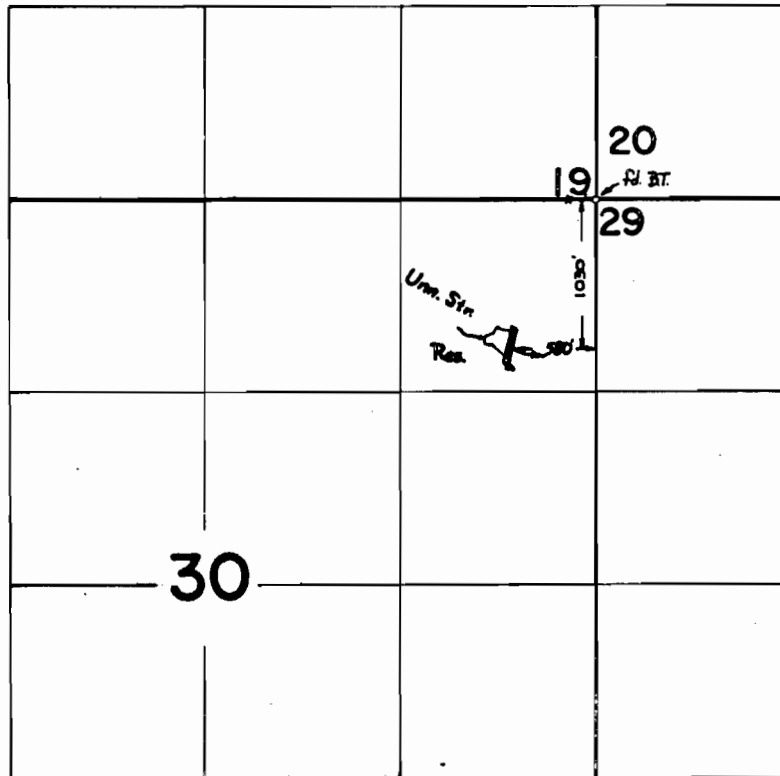

FINAL PROOF SURVEY

UNDER

R 43694

R 5019

Application No. 43759 Permit No. 32666

IN NAME OF

COE & MIRIAM LEAVENGOOD

Surveyed 3 APR 19 70, by D.R. BUELL