


# T.13S.R.1E.W.M.

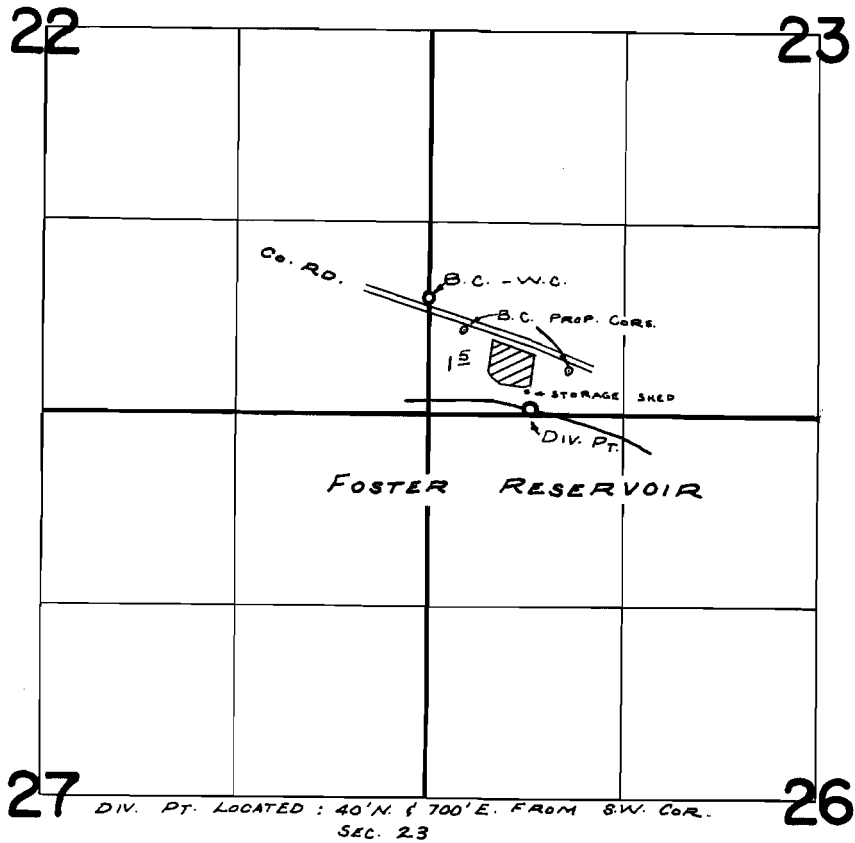

## FINAL PROOF SURVEY UNDER

Application No. 43744 Permit No. 32689  
IN NAME OF

SWEET HOME CEMETERY MAINTENANCE DISTRICT

Surveyed MAR. 25, 1970, by R. MUCKEN