


T.9S.R.3 & 4 E.W.M.

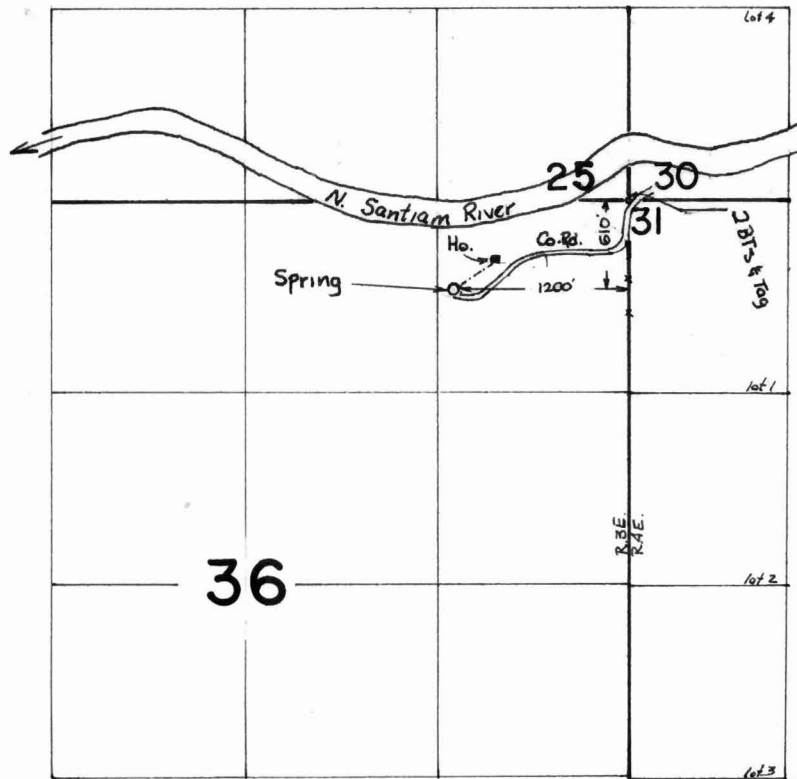

FINAL PROOF SURVEY

UNDER

Application No. 45684 Permit No. 34083

IN NAME OF

W. B. or VIOLA M. HIRTE

Surveyed 22 APR. 1970, by D. R. BUELL