


T.7S. R.2W. W.M.

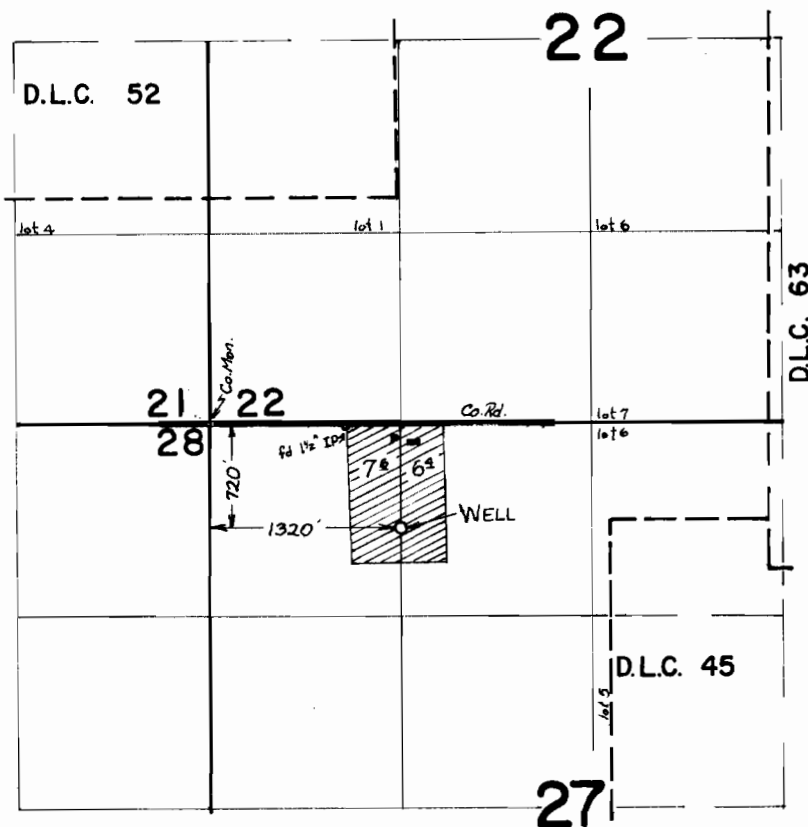

FINAL TR-OF SURVEY

G 3804

G3355

PROPERTY OF
EARL S. DOUGLAS

Surveyed 23 MAR 19 70, by D.R. BUELL