


# T. 7S. R. 2W. W.M.

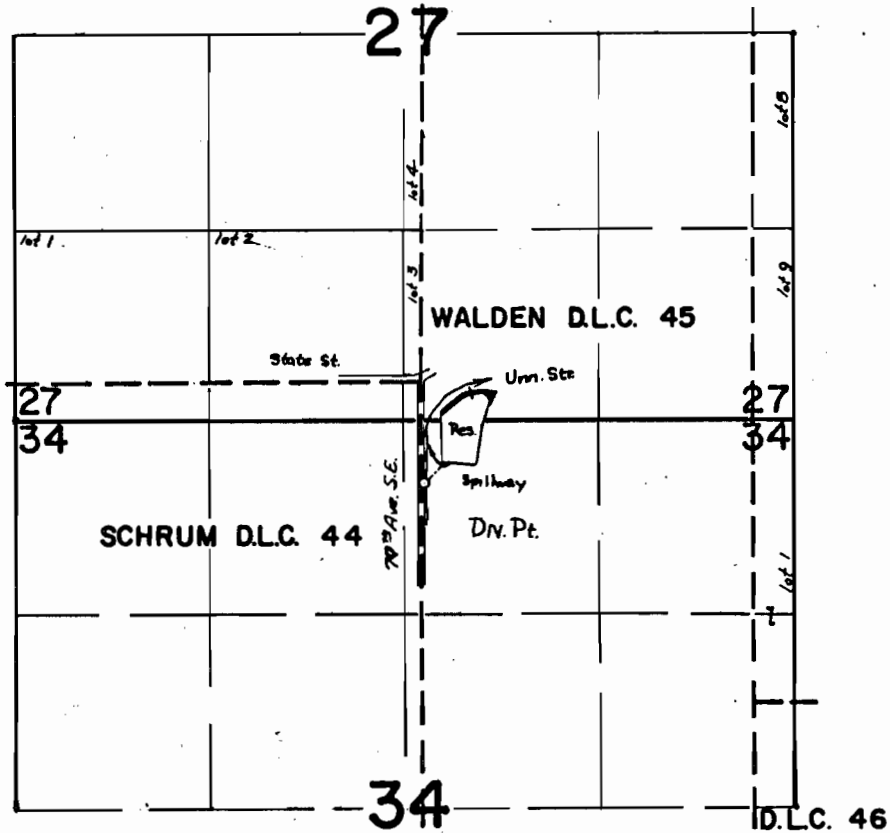

Div. Pt. loc.  $600' 54' 30'' E$  fm. N.E. Cor. Schrum D.L.C. 44.

## FINAL PROOF SURVEY

UNDER

R 43640

R 4953

Application No. 43641 Permit No. 32308

IN NAME OF

RALPH A. WILSON

Surveyed 23 MAR 1970, by D.R. BUELL