T.1N.R.3W.W.M.

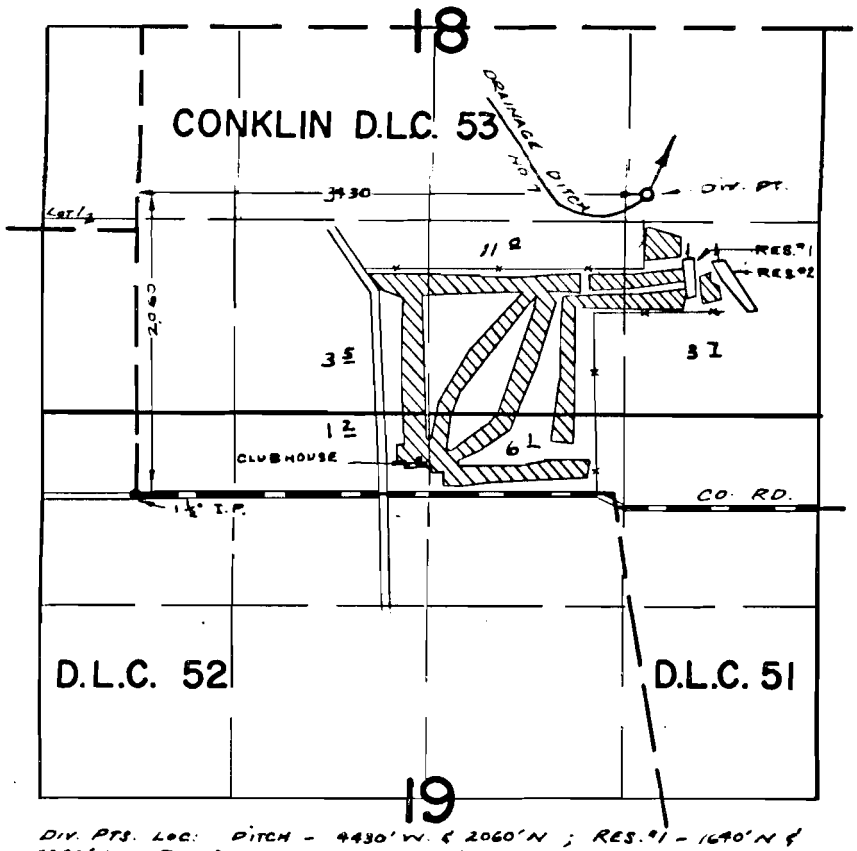

DIV. PTS. LOC: PITCH - 4430' W. & 2060' N ; RES. #1 - 1640' N & 4240' E ; RES. #2 - 1630' N. & 4450' E, ALL FROM S.W. COR. CONKLIN D.L.C. 53

FINAL PROOF SURVEY

UNDER

Application No. R40465 40466 Permit No. R4550 30266

IN NAME OF

WILLIAM SOHLER

Surveyed APR. 20, 1971, by R. MUCKEN

1971-J