


# T. 1 N. R. 4 W. W.M.

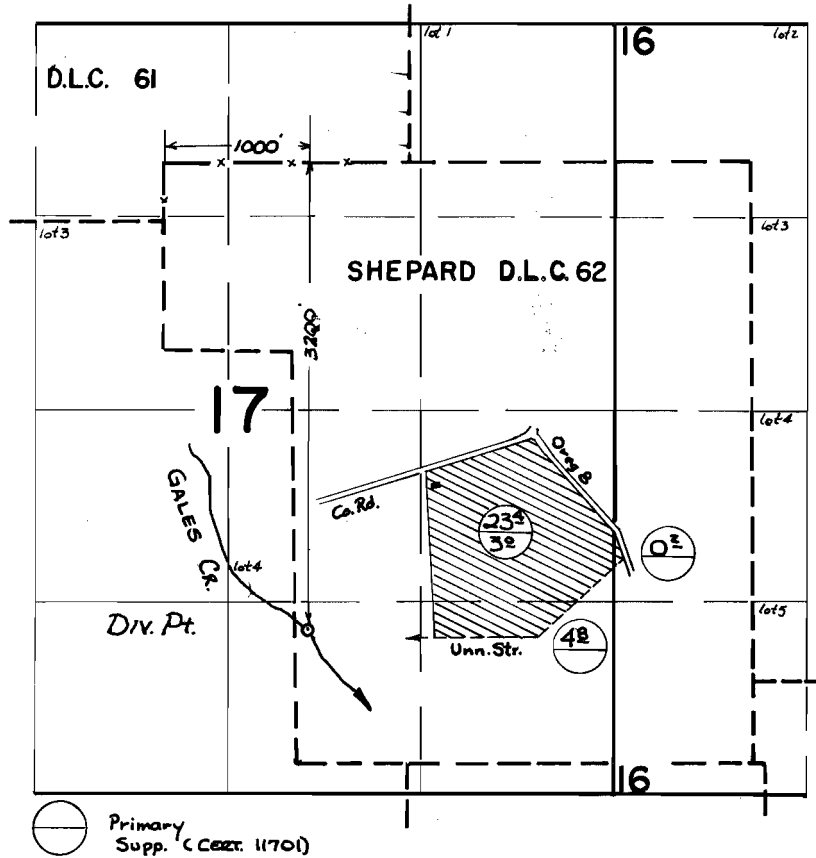

## FINAL PROOF SURVEY UNDER

Application No. 40819..... Permit No. 30411.....  
IN NAME OF

.....GEORGE L. AUSTIN.....

Surveyed 8.MAY..... 1969., by D.BUELL.....