


T.8 & 9 S. R. 39 E. W.M.

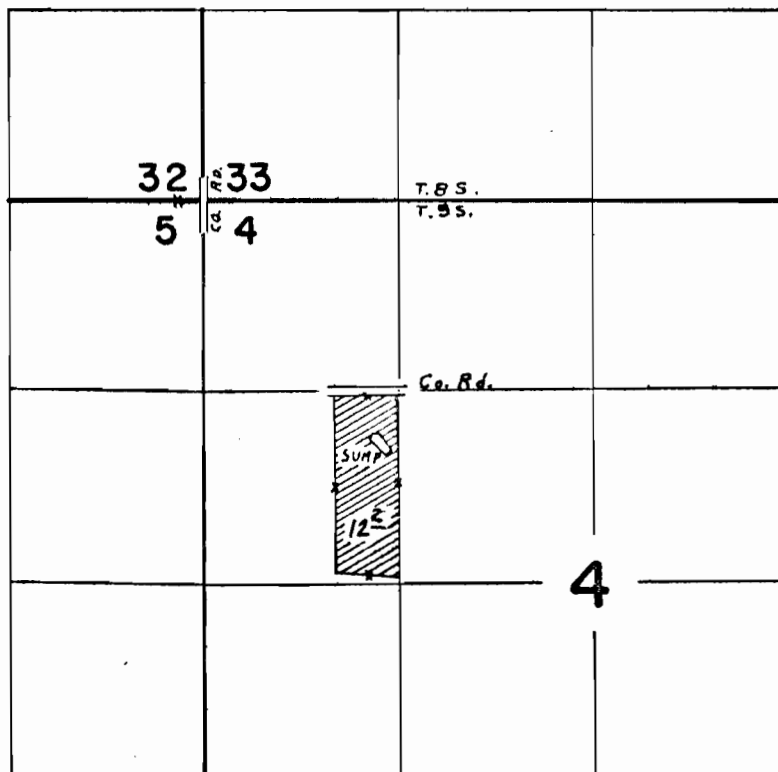

SUMP LOC. 1680'S. & 1160'E. FROM NW COR. SEC. 4

FINAL PROOF SURVEY

UNDER

Application No. G-3994 Permit No. G-3748

IN NAME OF

JAMES R. EVANS

Surveyed AUG. 4 19 70, by L.E. GOULD