


T.9S.R.40E.W.M.

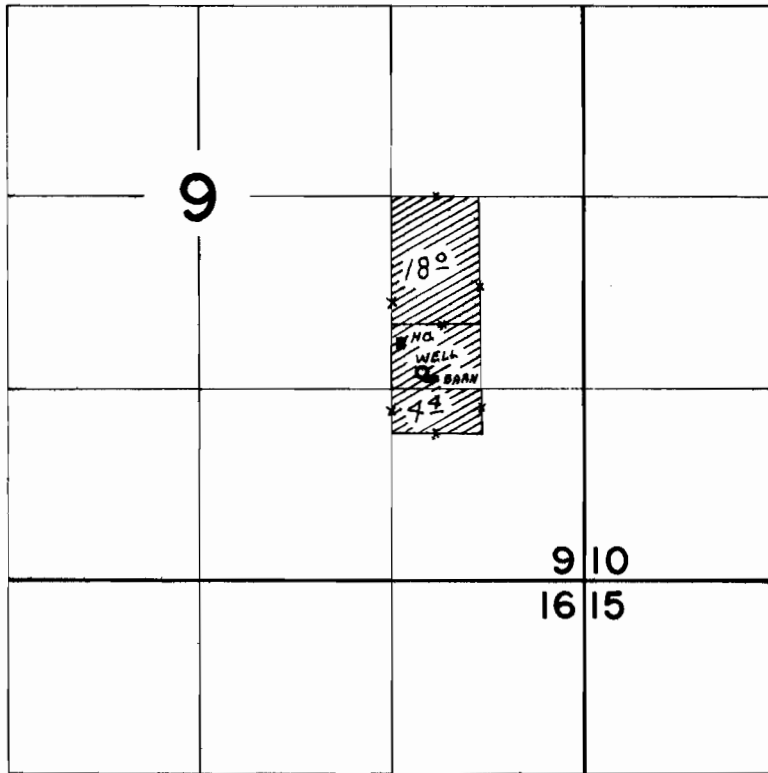

WELL LOC. 1220'S. & 210'E. FROM NW COR. NE ¼ SE ¼ SEC. 9

FINAL PROOF SURVEY

NO. 6-4776 ... NO. 6-4499

LEROY C. and HELENA N. WRIGHT

AUG. 5 70 L.E. GOULD