


# T. 9 S. R. 45 E. W. M.

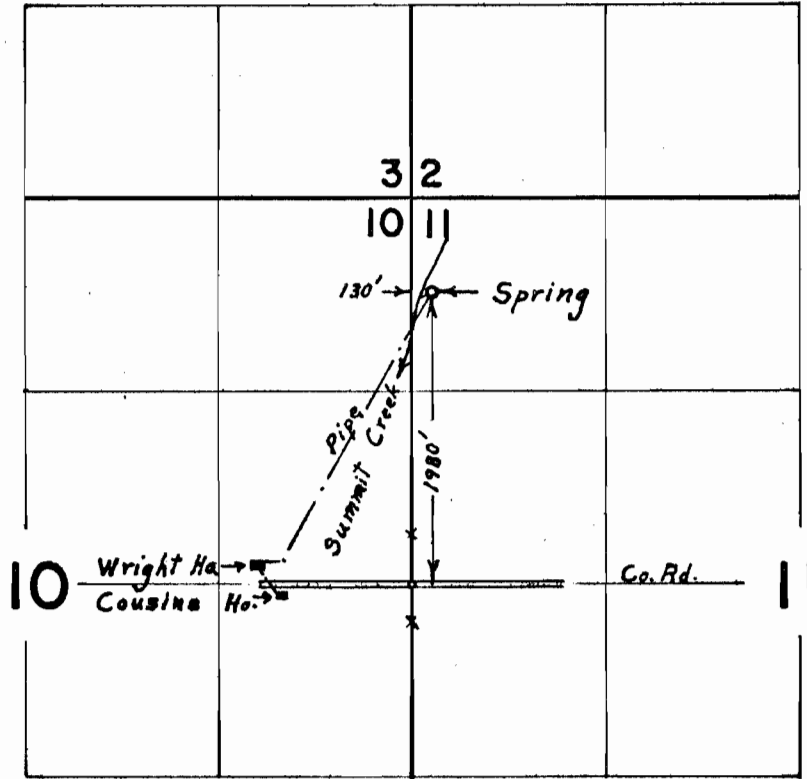

## FINAL PROOF SURVEY

UNDER

Application No. **38283** Permit No. **28517**

IN NAME OF

**GILL C. WRIGHT**

Surveyed **Aug. 13, 1970**, by **L. E. Gould**