


T. 9 S. R. 45 E. W. M.

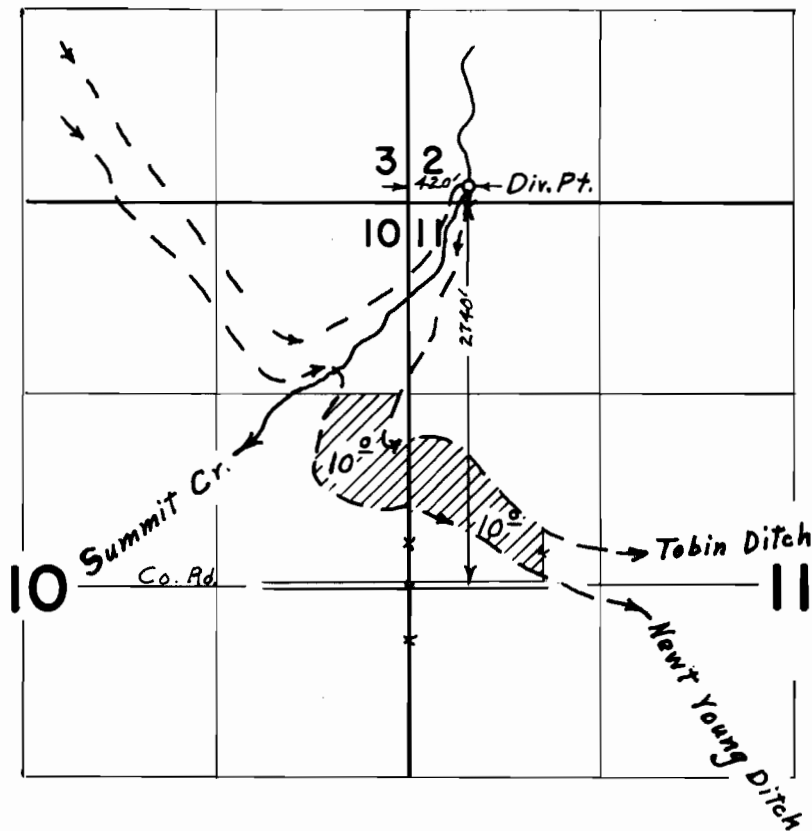

FINAL PROOF SURVEY UNDER

Application No. 42420 Permit No. 31742
IN NAME OF

GILL C. WRIGHT

Surveyed Aug. 13, 1970, by L. E. Gould