


# T. 9 S. R. 40 E. W. M.

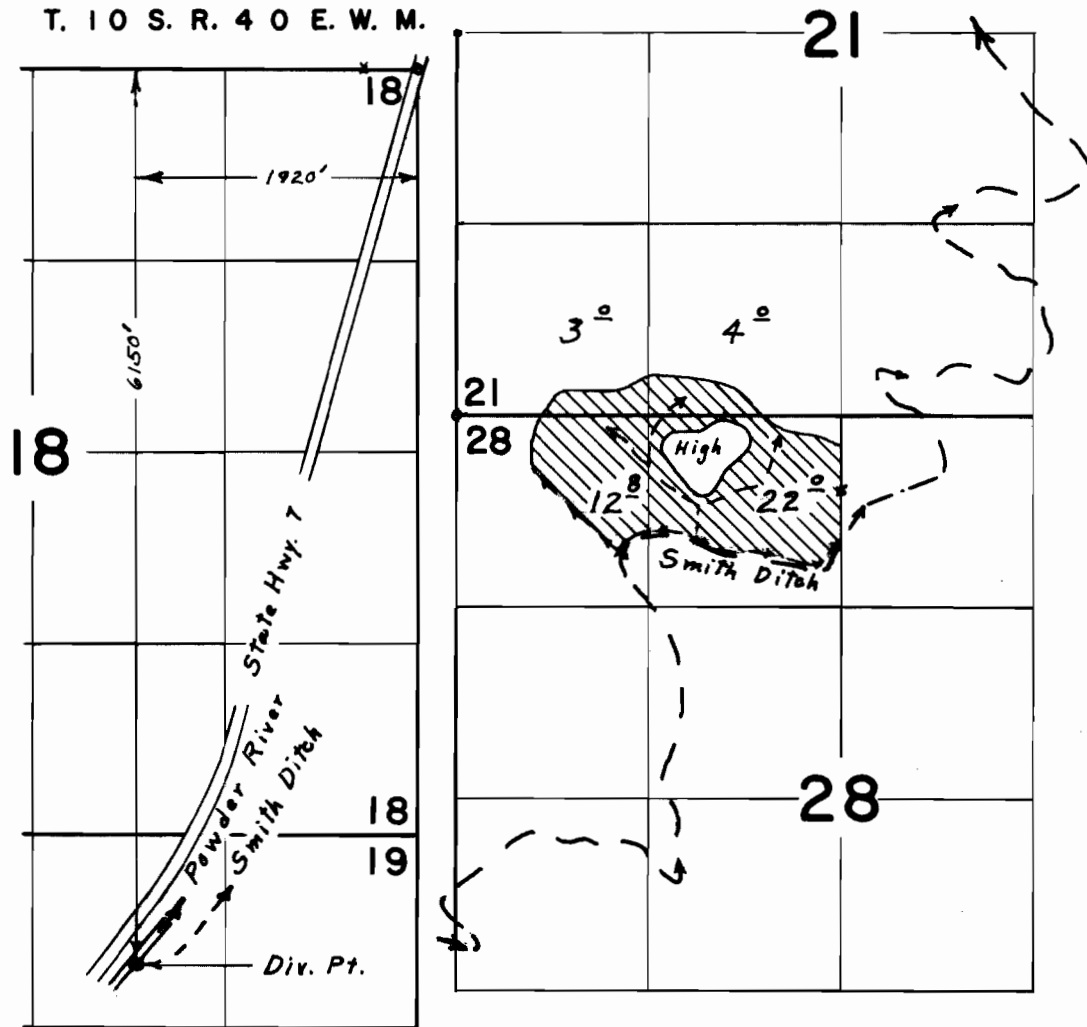

## FINAL PROOF SURVEY UNDER

Application No. 40391 Permit No. 30109  
IN NAME OF

GEORGE K. GUBLER

Surveyed Aug. 8, 1970, by L. E. Gould