


T.7S. R.46E.W.M.

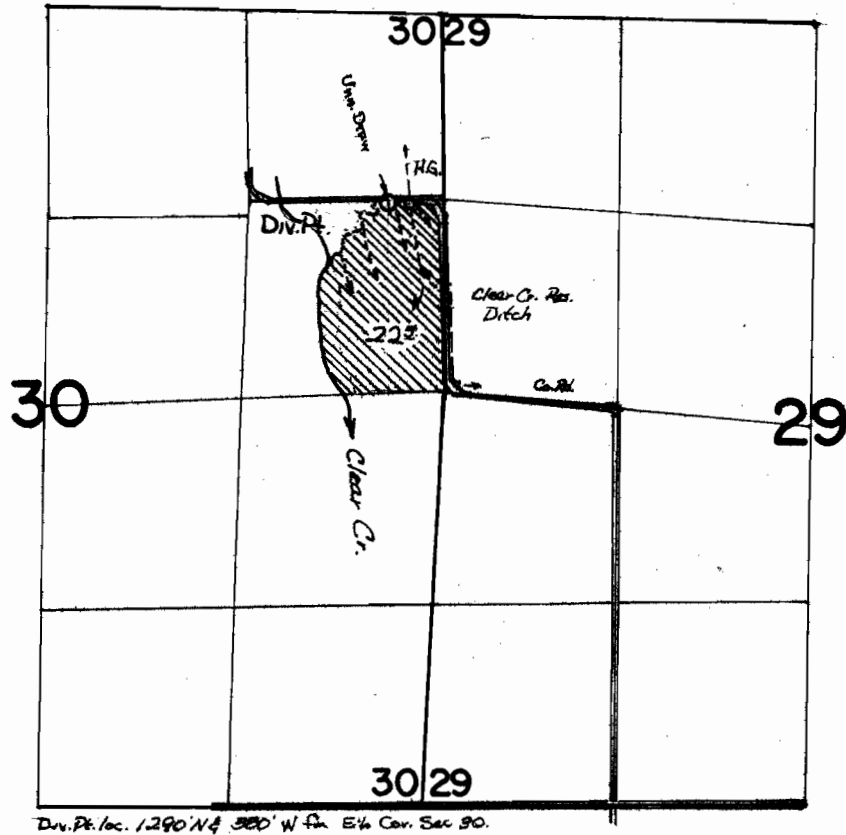

FINAL PROOF SURVEY

UNDER

Application No. 40439 Permit No. 30145

IN NAME OF

ROBERT HOWARD

Surveyed 18 JULY 1970, by D.R. BUELL