


T. 7 S. R. 44 E. W. M.

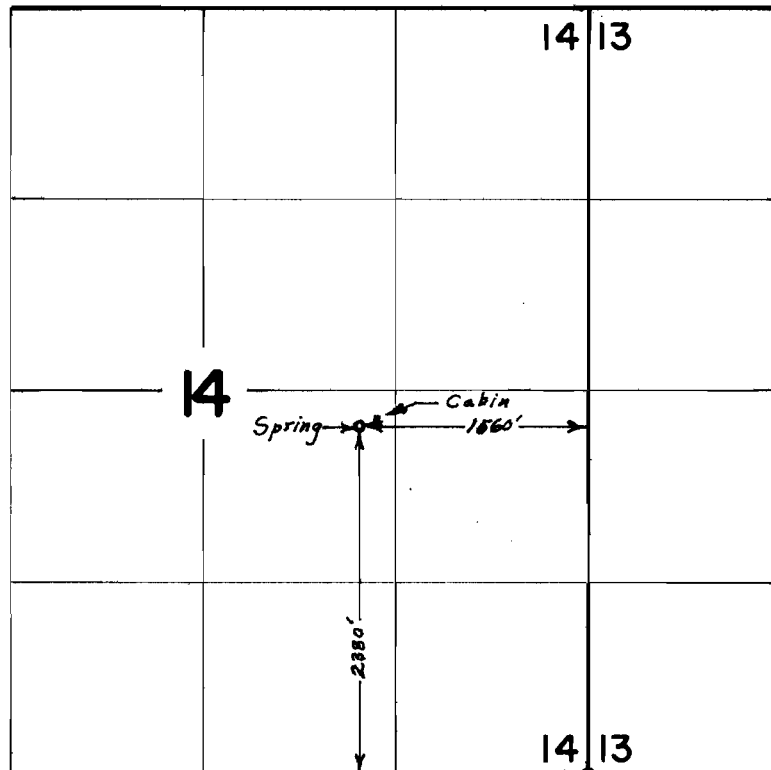

FINAL PROOF SURVEY

UNDER

Application No. 41520 Permit No. 30981

IN NAME OF

ROBERT F. CIESIEL

Surveyed Aug. 12, 1970, by L. E. Gould