


# T. 8 S. R. 4 | E. W. M.

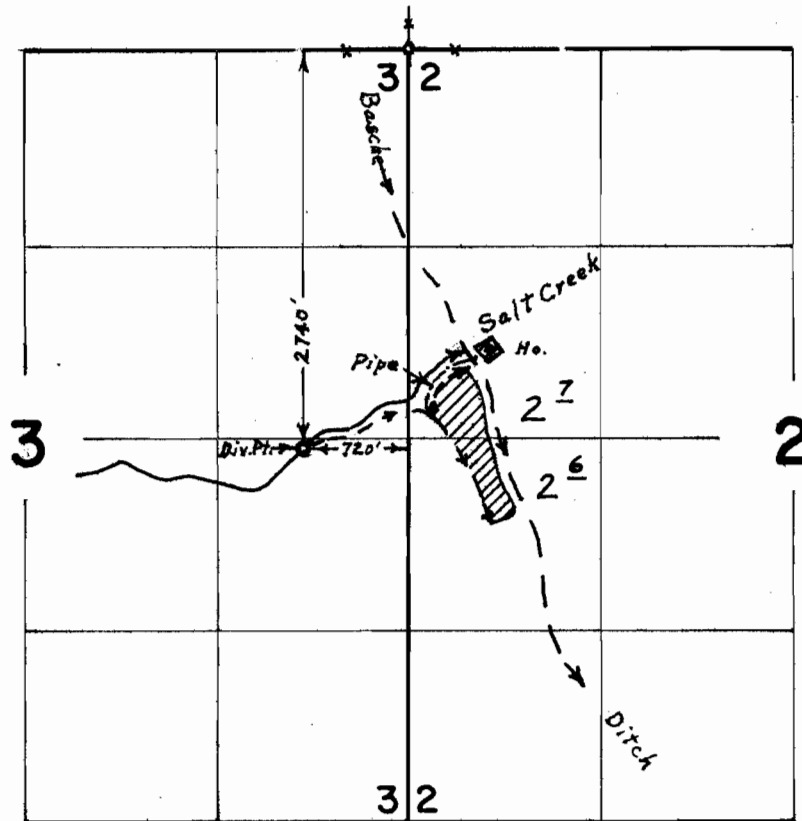

## FINAL PROOF SURVEY

UNDER

Application No. 42977 Permit No. 32108

IN NAME OF  
**JOHN B. KIRBY**

Surveyed July 17, 1970, by L. E. Gould