


T. 14 & 15 S. R. 5 W. W.M.

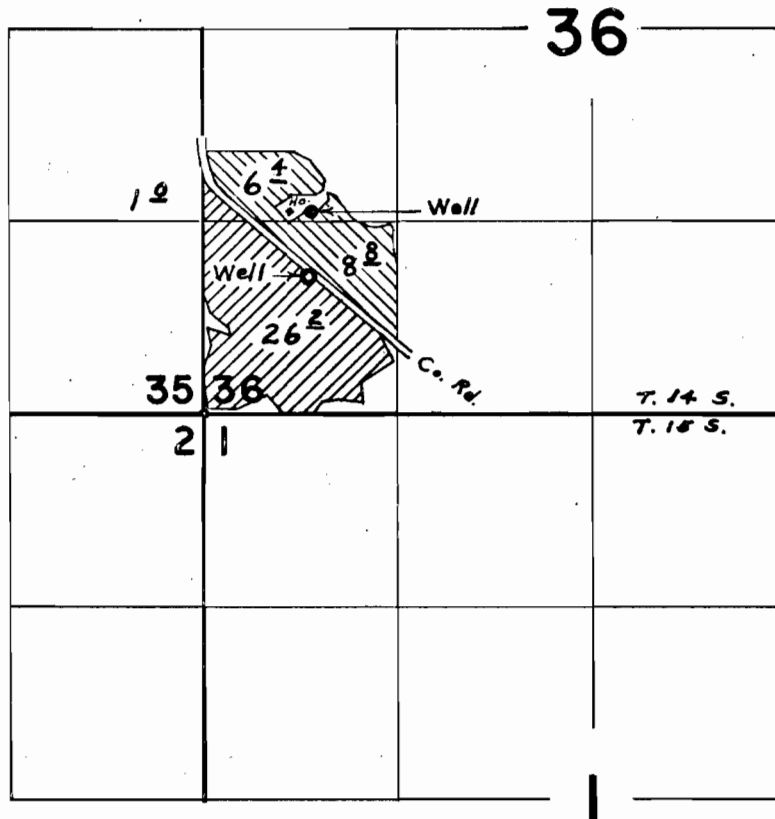

Wells located: 1380' N. & 730' E.; 940' N. & 720' E.;
both from S.W. Cor. Sec. 36

FINAL PROOF SURVEY

UNDER

Application No. G-2891 Permit No. G-2726
G-3970 G-3728



IN NAME OF

NETA V. BROWN, ESTATE

Surveyed May 7, 1970, by L. E. Gould