


T. 14 S. R. 5 W. W. M. .

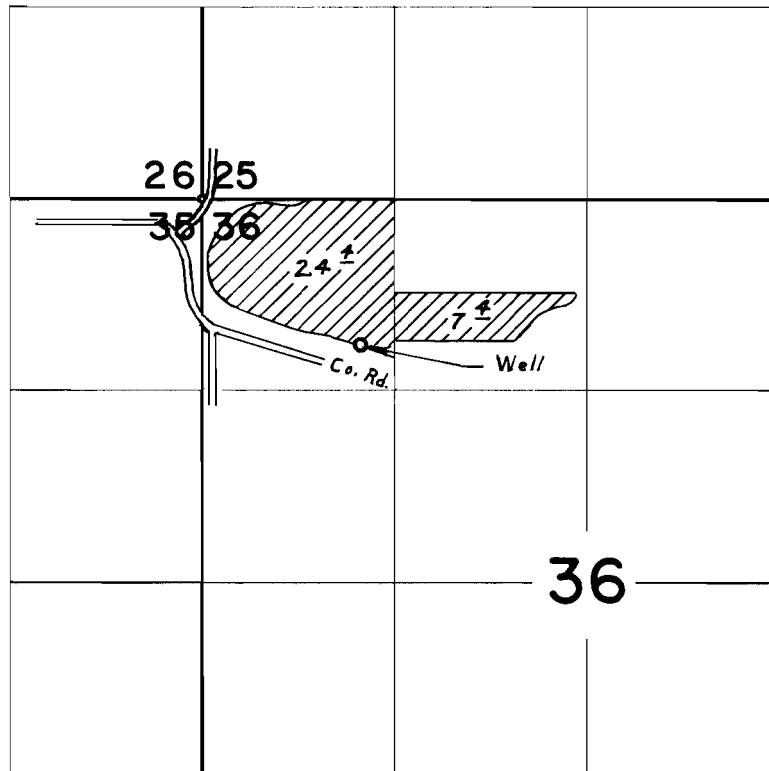

Well located 1000' S. & 1080' E. from NW. Cor. Sec. 36

FINAL PROOF SURVEY
UNDER

Application No. G-3295 Permit No. G-3118
IN NAME OF

ROBERT LOUIS FARVER

Surveyed Sept. 4., 1970, by L. E. Gould.