


T.15 S.R.4 & 5 W. W.M.

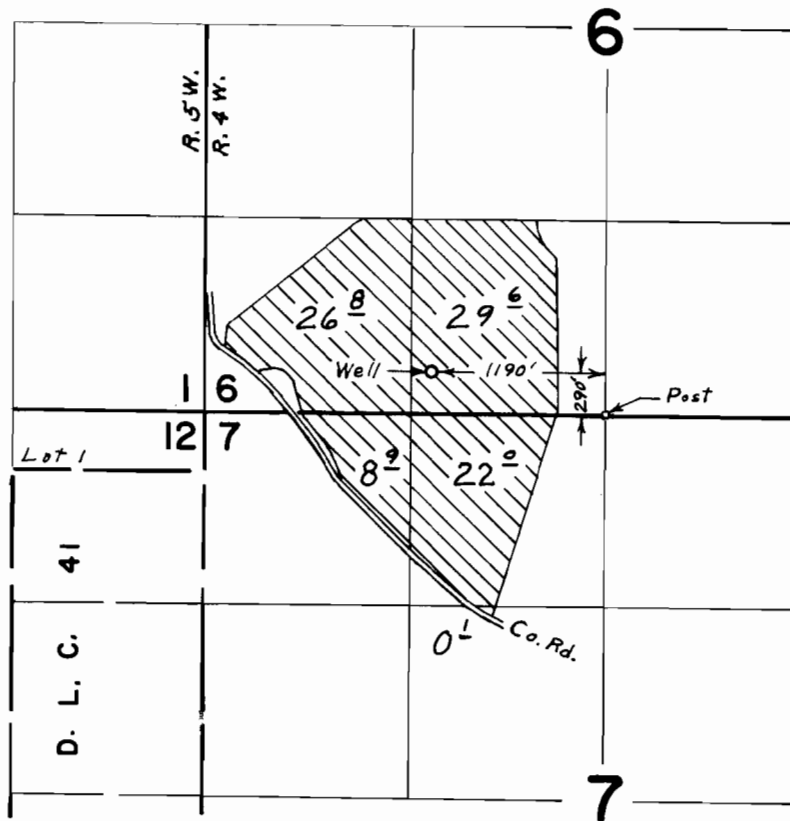

FINAL PROOF SURVEY UNDER

Application No. G-4675 Permit No. G-4403
IN NAME OF

EARL C. & RAYMOND JAGER

Surveyed Aug. 20, 1970, by L. E. Gould