


T. 14 S. R. 5 W. W. M.

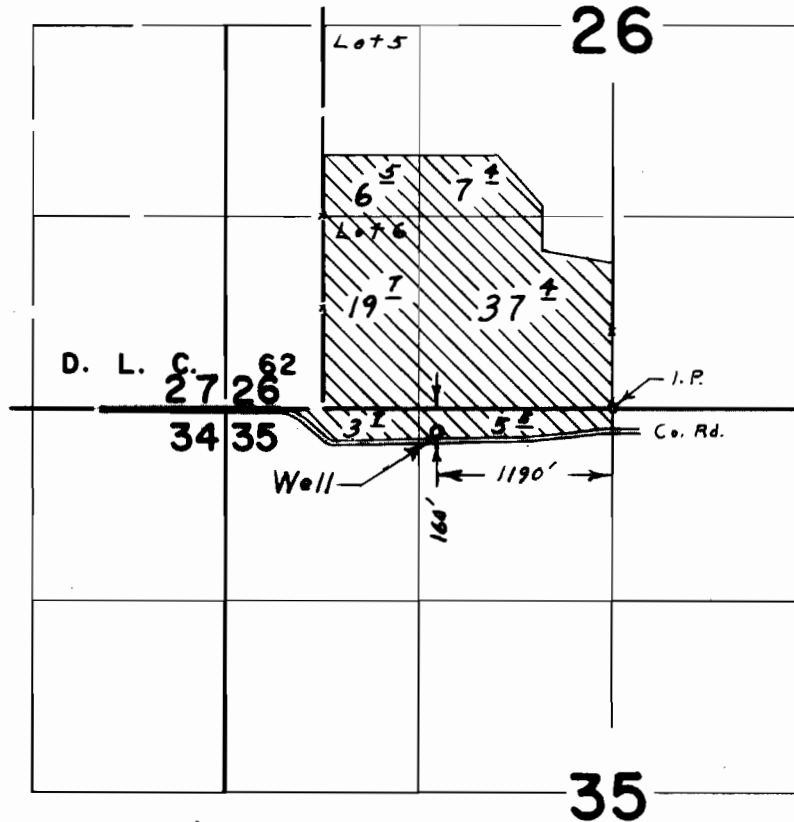

FINAL PROOF SURVEY UNDER

Application No. G-4930 Permit No. G-4654
IN NAME OF

J. CHESTER OAKES

Surveyed Sept. 4, 1970, by L. E. Gould