T. 14 S. R. 5 W. W. M.

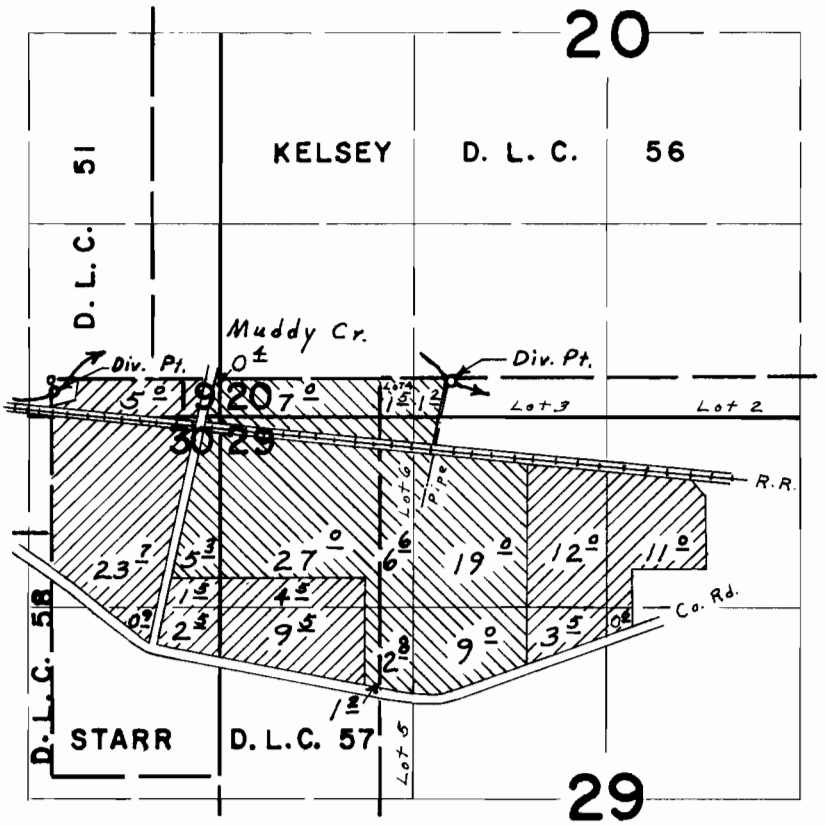

Div. Pts. located: 20' S. & 2730' E.; 80' S. & 30' E., both from N. W. Cor. Starr D. L. C. 57

FINAL PROOF SURVEY

UNDER

Application No. 37962 41979 Permit No. 28311 31421

IN NAME OF

PHILLIP ESTERGARD

Surveyed May 7, 1970, by L. E. Gould

1970-T