


T. 15 S. R. 4 W. W.M.

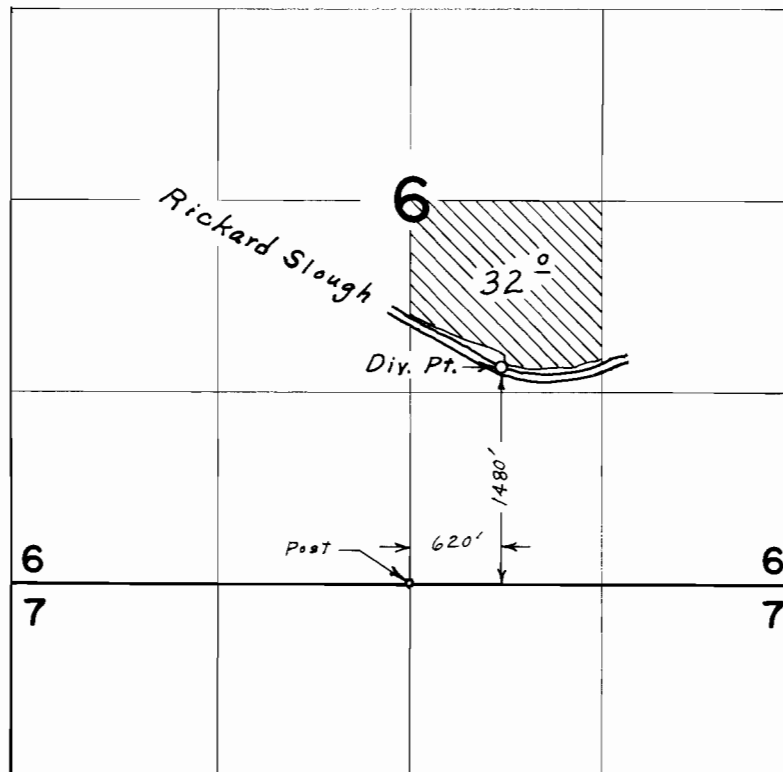

FINAL PROOF SURVEY
UNDER

Application No. 41708 Permit No. 31140
IN NAME OF

RAYMOND W. SMITH

Surveyed Aug. 21, 1970, by L. E. Gould