


T. 14 S. R. 5 W. W. M.

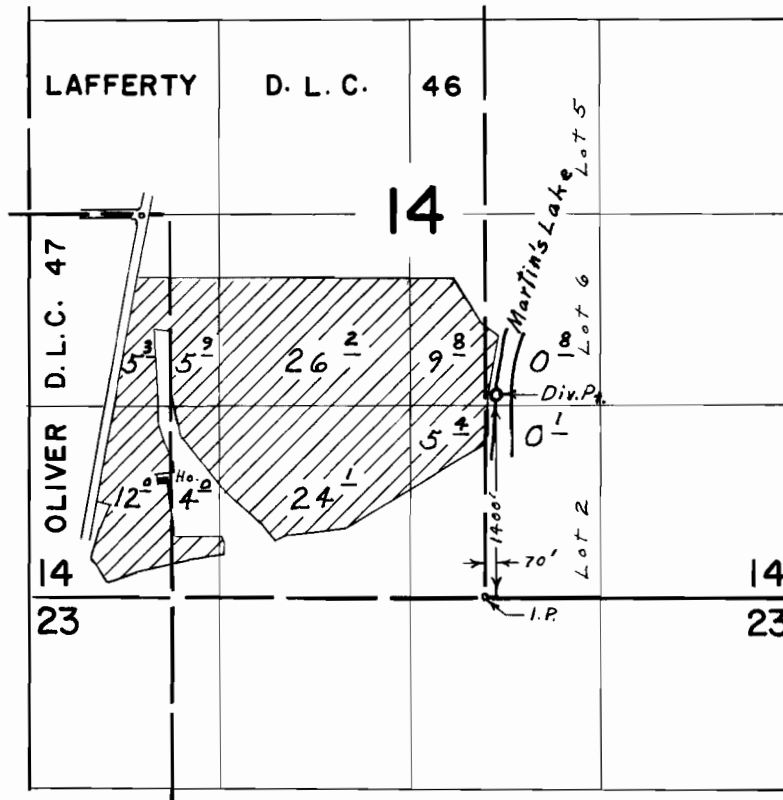

FINAL PROOF SURVEY UNDER

Application No. 42234 Permit No. 31607
IN NAME OF

CROCKER BROTHERS

Surveyed March 30, 1970, by L. E. Gould