


T.14 S.R.5 & 6 W.W.M.

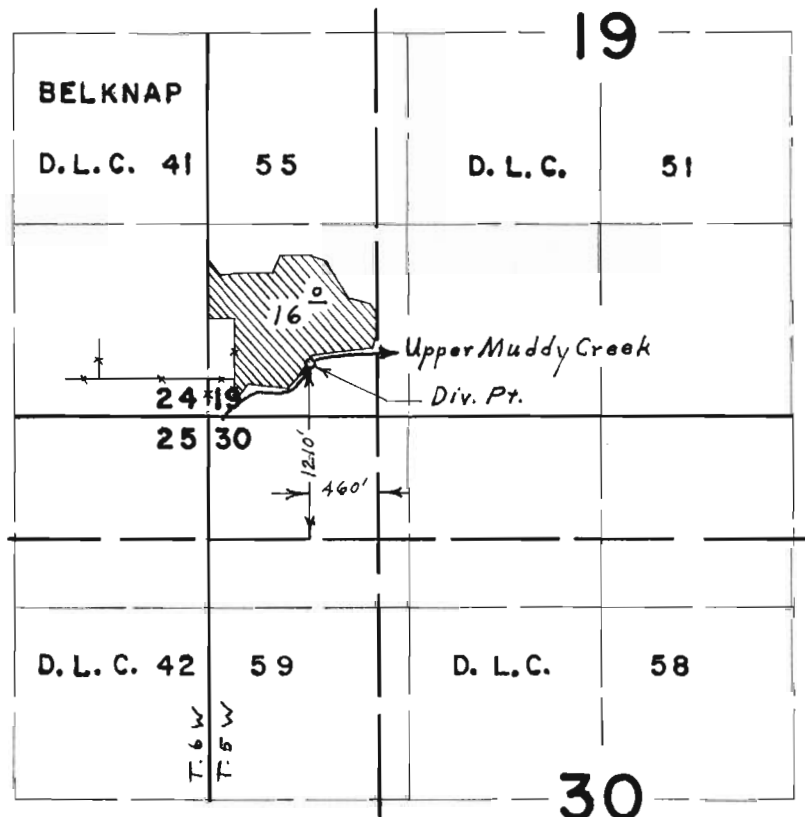

FINAL PROOF SURVEY

UNDER

Application No. 42335 Permit No. 31650

IN NAME OF

WALLACE & WILLARD TOTTEN

Surveyed April 20, 1970, by L. E. Gould