


T. 14 S. R. 5 W. W. M.

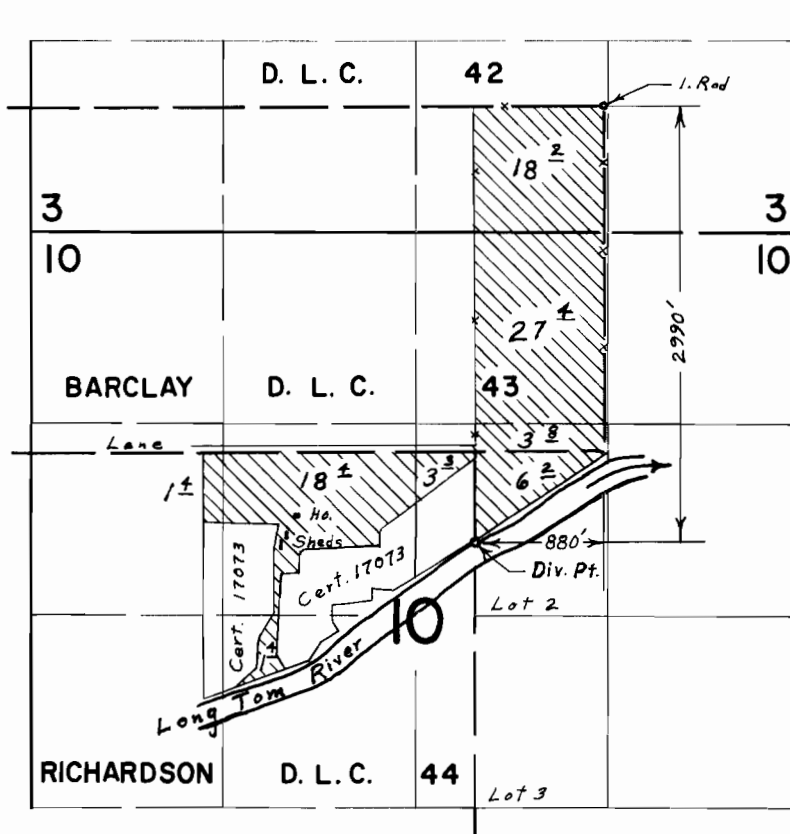

FINAL PROOF SURVEY UNDER

Application No. 42338 Permit No. 31652
IN NAME OF

CHARLES C. COLEGROVE

Surveyed March 25, 1970, by L. E. Gould