


# T. 14 S. R. 5 & 6 W. W.M.

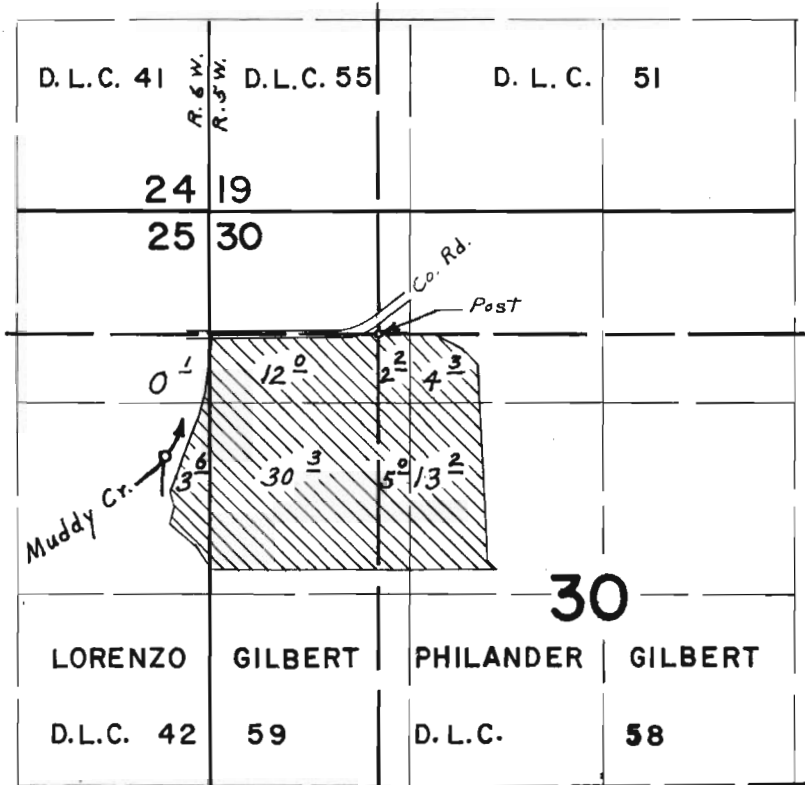

Div. Pt. located 830 ft S & 1460 ft W  
from NE corner Gilbert DLC 59

## FINAL PROOF SURVEY

UNDER

Application No. 42447 Permit No. 31755

IN NAME OF

**JAMES DAWSON**

Surveyed April 20, 1970, by L. E. Gould