


T. 5 S. R. 1 E. W. M.

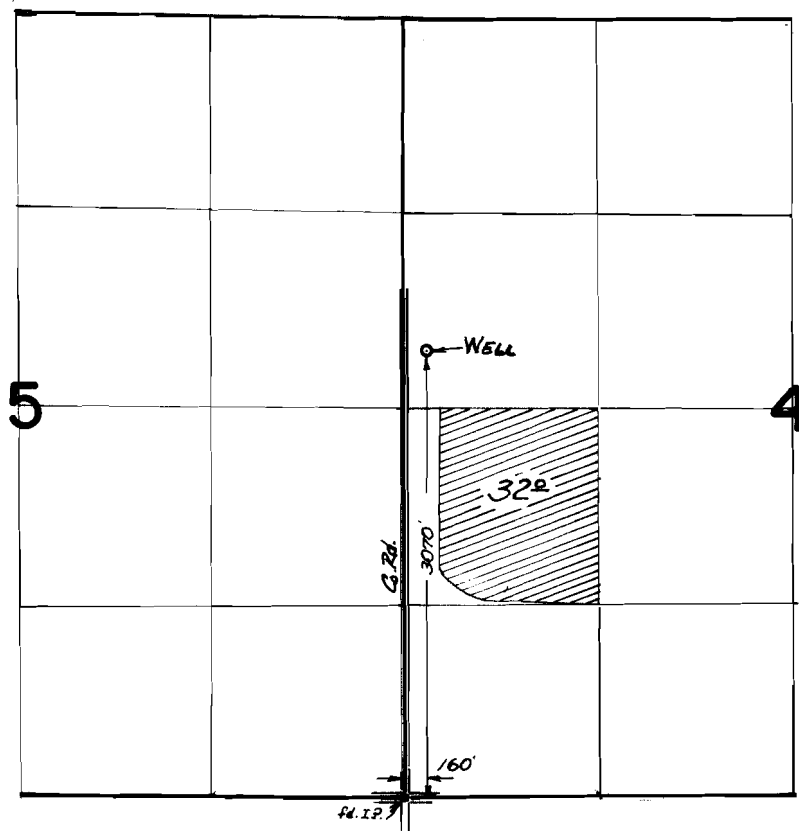

FINAL PROOF SURVEY UNDER

Application No. G. 5045... Permit No. G. 4755.....
IN NAME OF

.....LORIN L. YODER.....

Surveyed 2 OCT. 1970., by L. E. GOULD.....