


T.2S.R.3E.W.M.

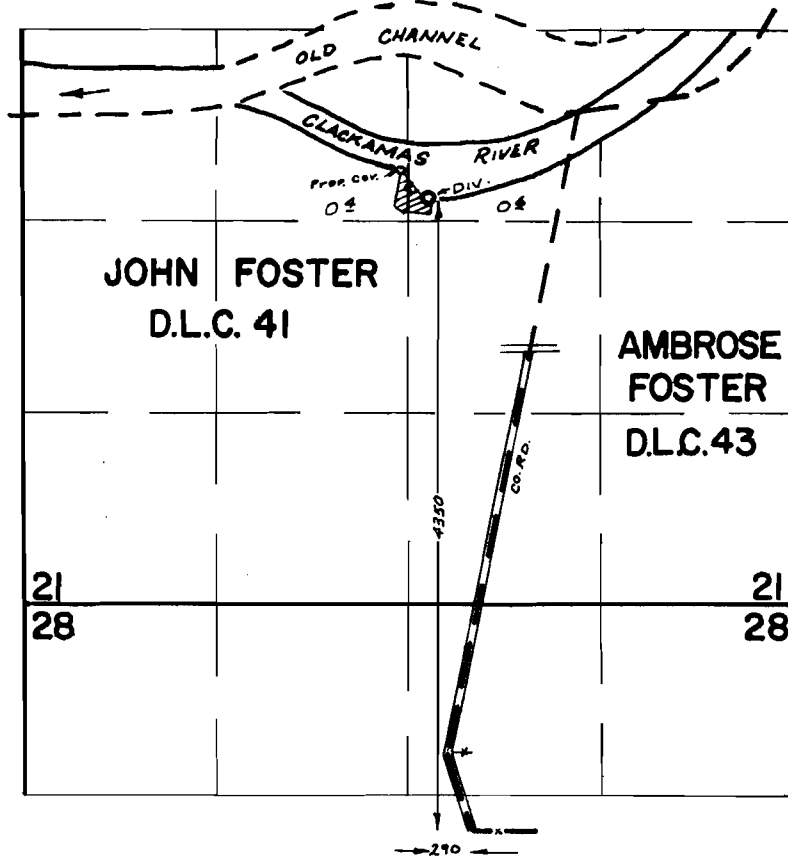

FINAL PROOF SURVEY

UNDER

Application No. 40914 Permit No. 30491

IN NAME OF

LAWRENCE L. SIMONIS

Surveyed Oct. 9, 1970, by R. MUCKEN